


STATE OF KANSAS
STATE CORPORATION COMMISSION

Form CP-4

Give All Information Completely
Make Required Affidavit
Mail or Deliver Report to:
Conservation Division
State Corporation Commission
212 No. Market
Wichita, Kansas 67202

WELL PLUGGING RECORD

Finney County, Sec. 29 Twp. 22S Rge. 33 (W)
Location as "NE/CNW/SW" or footage from lines C-SE-NW
Lease Owner Texaco Inc.
Lease Name Garden City "D" NCT-2 Well No. 1
Office Address P. O. Box 2420, Tulsa, Okla.
Character of Well (completed as Oil, Gas or Dry Hole) Dry
Date well completed 3-17-72 19
Application for plugging filed 10-8-73 19
Application for plugging approved 10-9-73 19
Plugging commenced 11-6-73 19
Plugging completed 11-7-73 19
Reason for abandonment of well or producing formation Dry

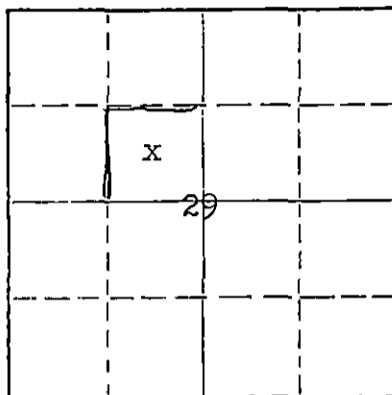

Locate well correctly on above
Section Plat

If a producing well is abandoned, date of last production 19
Was permission obtained from the Conservation Division or its agents before plugging was commenced? Yes

Name of Conservation Agent who supervised plugging of this well Ed Eyes
Producing formation _____ Depth to top _____ Bottom _____ Total Depth of Well 4852 Feet
Show depth and thickness of all water, oil and gas formations.

OIL, GAS OR WATER RECORDS

CASING RECORD

FORMATION	CONTENT	FROM	TO	SIZE	PUT IN	PULLED OUT
				9-5/8"	515'	None
				7"	4849'	1414'

Describe in detail the manner in which the well was plugged, indicating where the mud fluid was placed and the method or methods used in introducing it into the hole. If cement or other plugs were used, state the character of same and depth placed, from _____ feet to _____ feet for each plug set.

Well was plugged as follows:

From 2635-2503' w/hvy drlg mud, 2503-2310' w/25 sx cmt, 2310-514' w/hvy drlg mud, 514-414' w/40 sx cmt, 414-200' w/hvy drlg mud, 200-100' w/35 sx cmt, 100-45' w/hvy drlg mud, 45' to 0 w/15 sx cmt,

RECEIVED
STATE CORPORATION COMMISSION
JAN 2 1974
CONSERVATION DIVISION
Wichita, Kansas

(If additional description is necessary, use BACK of this sheet)

Name of Plugging Contractor Sargents Casing Pulling Service
Address _____

STATE OF Oklahoma, COUNTY OF Tulsa, ss.

J. E. LUNDAY (employee of owner) or (owner or operator) of the above-described well, being first duly sworn on oath, says: That I have knowledge of the facts, statements, and matters herein contained and the log of the above-described well as filed and that the same are true and correct. So help me God

(Signature)

J. E. Lunday
P. O. Box 2420, Tulsa, Okla. 74102
(Address)

SUBSCRIBED AND SWORN TO before me this 27th day of December, 19 73

My commission expires


11-25-74

Notary Public.

WELL LOG

COMPANY **Texaco, Inc.**
 FARM **Garden City "D" No. 1**
 TOTAL DEPTH **4852'**
 COMM. **11-23-71** COMP. **12-5-71**
 CONTRACTOR **Garvey Drilling Company**

SEC. **29** T. **22S** R. **33W**
 LOC. **C SE NW**
 COUNTY **Finney, Kansas**

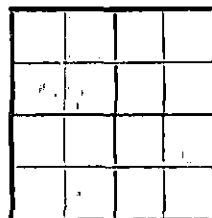

CASING
 9 5/8" @ 515' w/400ex
 7" @ 4849' w/200ex

ELEVATION

PRODUCTION

FIGURES INDICATE BOTTOM OF FORMATIONS

- 150' Clay & Soil
- 270' Sand
- 515' Shale
- 1386' Shale w/Lime streaks
- 1925' Shale
- 2790' Shale & Lime
- 2875' Shale w/Lime
- 3550' Lime & Shale
- 4535' Lime
- 4700' Lime & Shale
- 4770' Lime
- 4850' Lime
- 4852' Lime
- 4852' RTD

RECEIVED
 STATE CORPORATION COMMISSION
 OCT 9 1973
 CONSERVATION DIVISION
 Wichita, Kansas

State of Kansas }
 County of Barton } SS

I, Charlene Marker of Garvey Drilling Company
 upon oath state the above and foregoing is a true and correct copy of the log of the Garden City D-1 well.

Charlene Marker

Subscribed and sworn to before me this 9th day of December 19 71

My Commission Expires: July 8, 1974

James A. [Signature]
 NOTARY PUBLIC