


Give All Information Completely  
Make Required Affidavit  
Mail or Deliver Report to:  
Conservation Division  
State Corporation Commission  
211 No. Broadway  
Wichita, Kansas

WELL PLUGGING RECORD

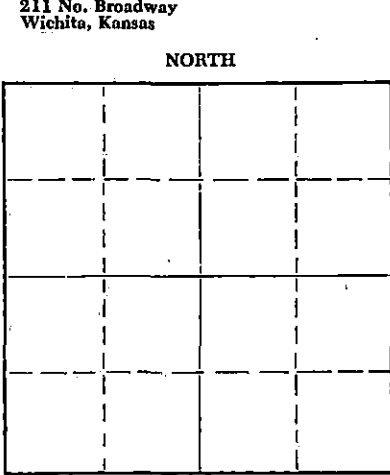

Locate well correctly on above  
Section Plat

Finney County. Sec. 33 Twp. 22 Rge. 33 (X) X (W)  
Location as "NE/CNW/SW" or footage from lines. SW NW SW  
Lease Owner Lonita Oil Corporation, Inc.  
Lease Name Damme "A" Well No. 3  
Office Address 704 Bitting Building, Wichita, Kansas  
Character of Well (completed as Oil, Gas or Dry Hole) Dry Hole  
Date well completed November 20 19 63  
Application for plugging filed November 20 19 63  
Application for plugging approved November 27 19 63  
Plugging commenced November 20 19 63  
Plugging completed November 20 19 63  
Reason for abandonment of well or producing formation Dry Hole

If a producing well is abandoned, date of last production \_\_\_\_\_ 19\_\_\_\_  
Was permission obtained from the Conservation Division or its agents before plugging was commenced? Yes

Name of Conservation Agent who supervised plugging of this well Hugh Scott, Sublette, Kansas  
Producing formation None Depth to top \_\_\_\_\_ Bottom \_\_\_\_\_ Total Depth of Well 4920 Feet  
Show depth and thickness of all water, oil and gas formations.

OIL, GAS OR WATER RECORDS

CASING RECORD

FORMATION	CONTENT	FROM	TO	SIZE	PUT IN	PULLED OUT
				8-5/8"	386'	None

Describe in detail the manner in which the well was plugged, indicating where the mud fluid was placed and the method or methods used in introducing it into the hole. If cement or other plugs were used, state the character of same and depth placed, from \_\_\_\_\_ feet to \_\_\_\_\_ feet for each plug set.

8-5/8" Surface, Common Cement circulated  
110 Sacks cement displaced thru Drill Pipe at 2700' to 2400'  
2400' to 700' with 45 Viscosity Mud 9 cc water loss  
Globe Plug placed at 700' and 25 sacks common cement displaced  
Globe Plug placed at 375' and 25 sacks common cement displaced  
Globe Plug placed at 40' and 10 sacks common cement displaced  
8-5/8" casing cut off and welded shut

RECEIVED  
STATE CORPORATION COMMISSION

DEC 2 1963

CONSERVATION DIVISION  
Wichita, Kansas

(If additional description is necessary, use BACK of this sheet)

Name of Plugging Contractor \_\_\_\_\_  
Address \_\_\_\_\_

STATE OF KANSAS, COUNTY OF SEDGWICK, ss.  
R. E. Hartman (employee of owner) or (owner or operator) of the above-described well, being first duly sworn on oath, says: That I have knowledge of the facts, statements, and matters herein contained and the log of the above-described well as filed and that the same are true and correct. So help me God.

(Signature) R. E. Hartman  
704 Bitting Building, Wichita, Kansas  
(Address)

SUBSCRIBED AND SWORN to before me this 29th day of November, 19 63

My commission expires November 28, 1964

Thomas H. Pappas  
Notary Public.



CERTIFIED DRILLER'S LOG

COMPANY: Lonita Oil Corporation, Inc.  
 CONTRACTOR: Lonita Oil Corporation, Inc.  
 COMMENCED: November 2, 1963  
 COMPLETED: November 20, 1963  
 ELEVATION: 2885' R.B.  
 LEASE: Damme "A" #3  
 LOCATION: SW NW SW, 33-22S-33W, Finney County, Kansas  
 CASING RECORD: 386' 8-5/8" cement with 275 sacks  
 Dry and Abandoned

<u>Formation</u>	<u>Depth</u>
Sand, Shale & Shells	0 - 1473
Shale & Shells	1473 - 1970
Anhydrite	1970 - 1985
Lime	1985 - 2276
Lime & Shale	2276 - 2815
Lime	2815 - 3237
Lime & Shale	3237 - 3298
Lime with Chalk	3298 - 3859
Lime	3859 - 4792
Sand	4792 - 4805
Lime & Shale	4805 - 4857
Lime	4857 - 4876
Lime & Sand	4876 - 4881
Lime	4881 - 4920
RTD	4920

I hereby certify that this is a true and correct copy of the above log to the best of my knowledge.

*R. E. Hartman*  
 R. E. HARTMAN

STATE OF KANSAS )  
 ) SS  
 COUNTY OF SEDGWICK )

Subscribed and sworn to before me this 26th day of November, 1963.

*Thomas H. Rippe*  
 Notary Public

My Commission Expires:  
 November 28, 1964

RECEIVED  
 STATE CORPORATION COMMISSION

DEC 2 1963

CONSERVATION DIVISION  
 Wichita, Kansas