


WELL PLUGGING RECORD

Give All Information Completely  
Make Required Affidavit  
Mail or Deliver Report to:  
Conservation Division  
State Corporation Commission  
800 Bittling Building  
Wichita, Kansas

FINNEY County. Sec. 1 Twp. 22S Rge. 34 (E) W. (W)

Location as "NE/CNW&SWK" or footage from lines NW NE SE  
Lease Owner JAY KORNFELD  
Lease Name GARDEN CITY Well No. 2  
Office Address 623 UNION NATIONAL BUILDING, WICHITA 2, KANSAS  
Character of Well (completed as Oil, Gas or Dry Hole) DRY HOLE  
Date well completed SEPTEMBER 21 19 57  
Application for plugging filed JUNE 27 19 58  
Application for plugging approved JUNE 30 19 58  
Plugging commenced AUGUST 19 19 58  
Plugging completed AUGUST 23 19 58  
Reason for abandonment of well or producing formation DRY

NORTH

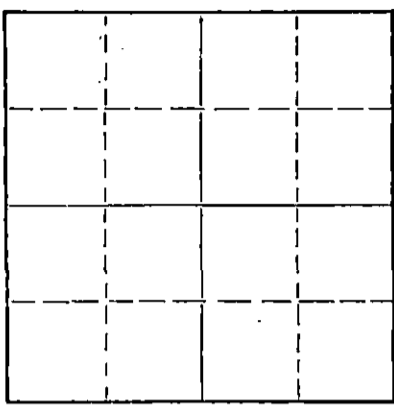

Locate well correctly on above Section Plat

If a producing well is abandoned, date of last production 19  
Was permission obtained from the Conservation Division or its agents before plugging was commenced? YES

Name of Conservation Agent who supervised plugging of this well MERLE RIVES  
Producing formation HUGOTON SERIES (GAS) Depth to top 2536 Bottom 2650 Total Depth of Well 2650 Feet  
Show depth and thickness of all water, oil and gas formations.

OIL, GAS OR WATER RECORDS

CASING RECORD

FORMATION	CONTENT	FROM	TO	SIZE	PUT IN	PULLED OUT
GAS SAND		2536	2650	5 1/2" 14#	2612'	1410'

Describe in detail the manner in which the well was plugged, indicating where the mud fluid was placed and the method or methods used in introducing it into the hole. If cement or other plugs were used, state the character of same and depth placed, from 2650 feet to feet for each plug set.

PLUG BACK WITH SAND TO 2455'.  
DUMPED 5 SACKS CEMENT. PULLED CASING TO 1000' AND CIRCULATED WITH GEL MUD.  
PULL CASING TO 300' AND SPOTTED 50 SACKS CEMENT. PULLED REMAINDER OF CASING.  
SET ROCK BRIDGE AT 35'.  
DUMPED 10 SACKS CEMENT TO BASE OF CELLAR.

RECEIVED  
STATE CORPORATION COMMISSION  
OCT 28 1958  
CONSERVATION DIVISION  
WICHITA, KANSAS

(If additional description is necessary, use BACK of this sheet)  
Name of Plugging Contractor ACE PIPE PULLING COMPANY  
Address P. O. BOX 304, GREAT BEND, KANSAS

STATE OF KANSAS, COUNTY OF SEDGWICK, ss.  
JAY KORNFELD (employee of owner, or owner or operator) of the above-described well, being first duly sworn on oath, says: That I have knowledge of the facts, statements, and matters herein contained and the log of the above-described well as filed and that the same are true and correct. So help me God.

(Signature) *Jay Kornfeld*  
623 UNION NATIONAL BUILDING, WICHITA 2, KANSAS  
(Address)

SUBSCRIBED AND SWORN to before me this 27<sup>th</sup> day of October, 1958.  
*Qua Janus Shelby*  
Notary Public.

My commission expires February 1, 1959

PLUGGING  
FILE SEC L T 22 R 34W  
BOOK PAGE 111 LINE 13

# WELL LOG

15-055-00303-0000

COMPANY JAY CORNFELD

SEC. 1 T. 22S R. 34W

FARM GARDEN CITY

NO. 2


LOC. Approx. C/N/2 N/2 SE

TOTAL DEPTH 2540'

COUNTY Finney Co., Kansas

COMM. September 18, 1957 COMP. September 21, 1957

CONTRACTOR GARVEY DRILLING COMPANY

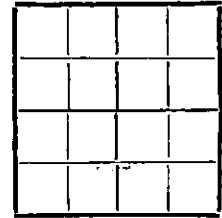

CASING 8 5/8" @ 210' W/200 sax.  
5 1/2" @ 2537.35' W/100 sax. used

2612' finished

ELEVATION

PRODUCTION

FIGURES INDICATE BOTTOM OF FORMATIONS

82 Pieces  
5 1/2" 14# X-55 pipe  
Cost 1,848.11  
\$585.88  
Total depth  
2650' @ 100 lbs

40	Clay & sand
220	Sand & shale
750	Shale & clay
1345	Red bed & shale
1375	Anhydrite
1685	Shale
2130	Shale & lime streaks
2540	Shale & lime
2540	T. D.

**PLUGGING**  
 FILE SEC. 1 T. 22 R. 34W  
 BOOK PAGE 111 LINE 13

**RECEIVED**  
 STATE CORPORATION COMMISSION  
 OCT 28 1958  
 CONSERVATION DIVISION  
 Wichita, Kansas

State of KANSAS }  
County of BARTON } SS:

I, Verne A. Morris of Garvey Drilling Co.

upon oath state that the above and foregoing is a true and correct copy of the log of the #2 Garden City well

Verne A. Morris

Subscribed and sworn to before me this 25th day of September 19 57

My Commission Expires: November 12, 1958

Branchbury  
NOTARY PUBLIC