


WELL PLUGGING RECORD

Give All Information Completely  
Make Required Affidavit  
Mail or Deliver Report to:  
Conservation Division  
State Corporation Commission  
800 Bitting Building  
Wichita, Kansas

NORTH

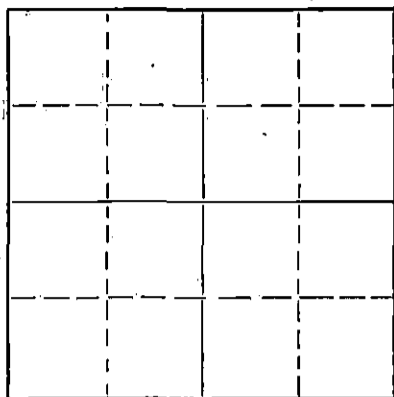

Locate well correctly on above  
Section Flat

Reno County, Sec. 14 Twp. 23 Rge. 10 (E) W. (W)  
Location as "NE/CNW/SW" or footage from lines 571' S. & 749' E. of N/4 Cor.  
Lease Owner Cities Service Oil Company  
Lease Name Sentney Well No. 1  
Office Address Bartlesville, Oklahoma  
Character of Well (completed as Oil, Gas or Dry Hole) Oil Well  
Date well completed May 3, 19 42  
Application for plugging filed October 19, 19 53  
Application for plugging approved October 21, 19 53  
Plugging commenced November 12, 19 53  
Plugging completed November 19, 19 53  
Reason for abandonment of well or producing formation Depleted formation.

If a producing well is abandoned, date of last production July 3, 19 53  
Was permission obtained from the Conservation Division or its agents before plugging was commenced? Yes

Name of Conservation Agent who supervised plugging of this well Warren H. Horner  
Producing formation Kansas City Depth to top 3729 Bottom 3729 Total Depth of Well 3758 Feet  
Show depth and thickness of all water, oil and gas formations. P. B. T. D. 3729'

OIL, GAS OR WATER RECORDS

CASING RECORD

FORMATION	CONTENT	FROM	TO	SIZE	PUT IN	PULLED OUT
				8-5/8"	251'	None
				5-1/2"	3778'	1660'

Describe in detail the manner in which the well was plugged, indicating where the mud fluid was placed and the method or methods used in introducing it into the hole. If cement or other plugs were used, state the character of same and depth placed, from \_\_\_\_\_ feet to \_\_\_\_\_ feet for each plug set.

3729-3290', mud.  
3290-3272', cement (6 sacks)  
3272- 250', mud.  
250- 240', rock bridge.  
240- 195', 15 sacks cement.  
195- 20', mud.  
20- 15', rock bridge.  
15' to base of cellar, 15 sacks cement.

11-25-53


(If additional description is necessary, use BACK of this sheet)  
Name of Plugging Contractor B. & W. Casing Pulling Company  
Address Great Bend, Kansas

STATE OF Kansas, COUNTY OF Barton, ss.  
V. M. Conover (employee of owner) or ~~owner or operator~~ of the above-described well, being first duly sworn on oath, says: That I have knowledge of the facts, statements, and matters herein contained and the log of the above-described well as filed and that the same are true and correct. So help me God.

(Signature) V.M. Conover  
Box 751, Great Bend, Kansas  
(Address)

SUBSCRIBED AND SWORN TO before me this 23rd day of November 19 53

My commission expires March 12, 1955. N. G. Smith Notary Public.

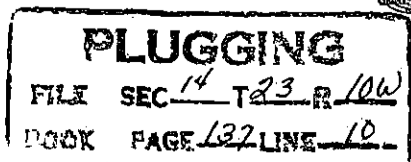

WELL RECORD

Company Cities Service Oil Co. Well No. 1 Farm Sentney  
 Location 571' S. & 749' E. of N/4 Corner Sec. 14 T. 23 R. 10W  
 Elevation 1759 County Reno State Kansas  
 Drlg. Comm. April 13, 1942 Contractor Corbett-Barbour Drilling Company  
 Drlg. Comp. May 3, 1942 Acid 500 gallons - May 5, 1942  
 T. D. 3758' Initial Prod. B. H. P. Gauge potential: 3000 oil, no water, 24 hrs.  
 (Ind. cap. 3000 bbls.)

CASING RECORD:

8-5/8"  $\pi$  248' con. 125 ex Red Wing &  
 2 ex C. G.  
 5-1/2"  $\sigma$  3746' con. 125 ex Ash Grove

3748 rotary T. D. = 3747 S. L. M.  
 lime 3758 T. D.

FORMATION RECORD:

sand	0-95
red bed & shells	246
sand rock	248
shale & red bed	410
anhydrite	445
red bed	550
shale & shells	690
red bed	795
salt & shale	950
salt	1150
shale & shells	1200
shale	1320
lime	1440
anhydrite & lime	1490
lime & shale	1520
sandy lime	1538
lime	1680
shale	1730
broken lime	1745
sand	1770
lime	1910
broken lime	2175
shale	2187
shale & lime	2420
shale & shells	2540
shale & lime	2675
lime	2725
shale	2765
lime	2997
broken lime	3080
shale	3158
lime & shale	3178
lime (odor in sample 3290-3300)	3589
lime & chert	3594
shale & shells	3634
shale	3745
lime	3748

Corr. top Viola 3744'  
 Penetration 14'  
 Total Depth 3758'

Loaded hole with 2500' water before drilling in.

Pay 3755-58, no fillup.

Syfo: 500' 0°  
 1000' 1/2°  
 1500' 1°  
 2000' 0°  
 2500' 0°  
 3000' 0°  
 3500' 0°

RECEIVED  
 CORPORATION COMMISSION

OCT 21 1953

CORPORATION DIVISION  
 Wichita, Kansas

PLUGGING  
 FILE SEC 14 T 23 R 10W  
 BOOK PAGE 32 LINE 10