


WELL PLUGGING RECORD

Give All Information Completely
Make Required Affidavit
Mail or Deliver Report to:
Conservation Division
State Corporation Commission
211 No. Broadway
Wichita, Kansas

Reno County, Sec. 14, Twp. 23, Rge. 10 (E) W. (W)

Location as "NE/CNW%SW%" or footage from lines NE NW NW
Lease Owner Cities Service Oil Company
Lease Name Estey Well No. 1
Office Address Box 144, Great Bend, Kansas
Character of Well (completed as Oil, Gas or Dry Hole) Oil well
Date well completed February 3, 19 42
Application for plugging filed March 19, 19 57
Application for plugging approved March 20, 19 57
Plugging commenced April 14, 19 57
Plugging completed April 19, 19 57
Reason for abandonment of well or producing formation Depleted formation.

NORTH

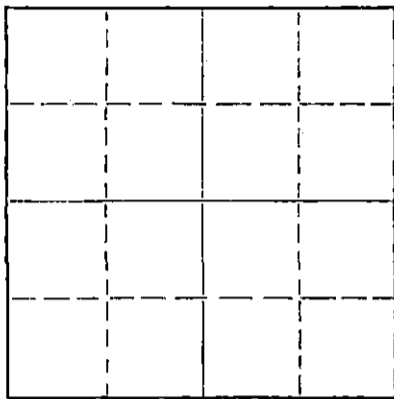

Locate well correctly on above
Section Plat

If a producing well is abandoned, date of last production March 2, 19 57
Was permission obtained from the Conservation Division or its agents before plugging was commenced? Yes

Name of Conservation Agent who supervised plugging of this well Ruel Durkee
Producing formation Viola Depth to top 3758 Bottom 3770 Total Depth of Well 3770 Feet
Show depth and thickness of all water, oil and gas formations.

OIL, GAS OR WATER RECORDS

CASING RECORD

FORMATION	CONTENT	FROM	TO	SIZE	PUT IN	PULLED OUT
				8-5/8"	225'	None
				5-1/2"	3759'	1681'

Describe in detail the manner in which the well was plugged, indicating where the mud fluid was placed and the method or methods used in introducing it into the hole. If cement or other plugs were used, state the character of same and depth placed, from _____ feet to _____ feet for each plug set.

3770-3750', river sand.
3750-3702', 6 sacks cement.
3702- 200', heavy mud.
200- 140', rock bridge and 15 sacks cement.
140- 20', heavy mud.
20' to base of cellar, rock bridge and 5 sacks cement.

(If additional description is necessary, use BACK of this sheet)

Name of Plugging Contractor G. E. Shull Casing Pulling Company
Address Great Bend, Kansas

STATE OF Kansas, COUNTY OF Barton, ss.
V. M. Conover (employee of owner) or (owner/operator) of the above-described

well, being first duly sworn on oath, says: That I have knowledge of the facts, statements, and matters herein contained and the log of the above-described well as filed and that the same are true and correct. So help me God.

(Signature) V. M. Conover

Box 144, Great Bend, Kansas
(Address)

SUBSCRIBED AND SWORN TO before me this 24th day of April, 19 57

W. B. Smith
Notary Public.

My commission expires March 12, 1959.

PLUGGING
FILE SEC. 14 T. 23 R. 10W
BOOK PAGE 149 LINE 24

APR 25 1957 4-25-57
CONSERVATION DIVISION
Wichita, Kansas

WELL RECORD

15-155-01831-0000

Company Cities Service Oil Co. Well No. 1 Farm Estoy
 Location 330' south & 990' east of NW Corner Sec. 14 T. 23 R. 10W
 Elevation 1767 County Reno State Kansas
 Drig. Comm. January 16, 1942 Contractor Hinson Drilling Company
 Drig. Comp. February 3, 1942 Acid 500 gals. Feb. 4, 1942
 T. D. 3770' Initial Prod. B. H. P. Gauge Potential: 3000 oil, no water, 24 hours
 (Ind. capacity 22,812 bbls.)

CASING RECORD:

8-5/8" @ 225' com. 200 sx cement
 5-1/2" @ 3759' com. 75 sx Ash Grove

FORMATION RECORD:

surface	0-40
shale & sand	220
lime	225
shale & red bed	430
anhydrite	468
shale	1000
salt & shale	1250
shale & shells	1365
lime & shale	1579
lime	1755
sandy lime	1770
lime	1833
lime & shale	1993
lime	2098
lime & shale	2845
lime	3202
lime & shale	3245
sand & lime	3269
lime	3581
lime & chert	3626
lime	3663
shale & lime	3757
lime	3761

3761 Rot. TD = 3761 SLM
 Dolomite & chert 3770 T. D.

Top Viola 3758'
 Penetration 12'
 Total Depth 3770'

Loaded hole with 2750' water before drilling-in.

No fillup at 3770.

Syfo: 500' 0°
 1000' 0°
 1500' 0°
 2000' 0°
 2500' 0°
 3000' 0°
 3500' 0°

PLUGGING
 FILE SEC. 14 T. 23. R. 10W
 BOOK PAGE 149 LINE 24

RECEIVED
 MIN. COMMISSIONER
 FEB 20 1942
 DIVISION
 Kansas