


WELL PLUGGING RECORD

Give All Information Completely
Make Required Affidavit
Mail or Deliver Report to:
Conservation Division
State Corporation Commission
211 No. Broadway
Wichita, Kansas

Finney County, Sec. 17 Twp. 22 Rge. 33 (X) W (W)

Location as "NE/CNW%SW%" or footage from lines SE NW SW
Lease Owner Lonita Oil Corporation, Inc.
Lease Name Garden City Company "A" Well No. 3
Office Address 704 Bitting Building, Wichita, Kansas 67202
Character of Well (completed as Oil, Gas or Dry Hole) Dry Hole
Date well completed October 31, 19 63
Application for plugging filed October 31, 19 63
Application for plugging approved November 5, 19 63
Plugging commenced October 31, 19 63
Plugging completed October 31, 19 63
Reason for abandonment of well or producing formation Dry Hole

NORTH

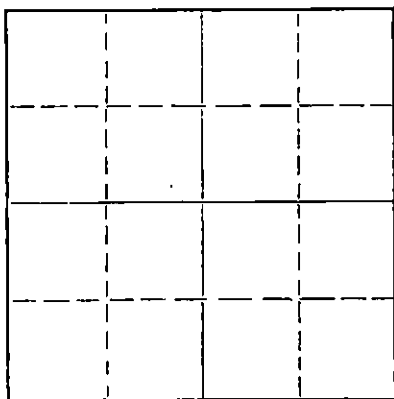

Locate well correctly on above
Section Plat

If a producing well is abandoned, date of last production _____ 19____
Was permission obtained from the Conservation Division or its agents before plugging was commenced? Yes

Name of Conservation Agent who supervised plugging of this well Hugh Scott, Sublette, Kansas
Producing formation None Depth to top _____ Bottom _____ Total Depth of Well 4870 Feet
Show depth and thickness of all water, oil and gas formations.

OIL, GAS OR WATER RECORDS

CASING RECORD

FORMATION	CONTENT	FROM	TO	SIZE	PUT IN	PULLED OUT
				8-5/8"	378'	None

Describe in detail the manner in which the well was plugged, indicating where the mud fluid was placed and the method or methods used in introducing it into the hole. If cement or other plugs were used, state the character of same and depth placed, from _____ feet to _____ feet for each plug set.

8-5/8" Surface, Common Cement Circulated
105 sacks common cement displaced thru Drill Pipe at
2700' to 2400'.
2400' to 700' with 52 Viscosity mud 9.5 cc Water Loss.
Globe Plug placed at 700' and 25 sacks common cement displaced.
Globe Plug placed at 375' and 25 sacks common cement displaced.
Globe Plug placed at 40' and 10 sacks common cement displaced.
8-5/8" Casing cut off and welded shut.

RECEIVED
STATE CORPORATION COMMISSION

11-12-63 NOV 12 1963

CONSERVATION DIVISION
Wichita, Kansas

(If additional description is necessary, use BACK of this sheet)

Name of Plugging Contractor _____
Address _____

STATE OF KANSAS, COUNTY OF SEDGWICK, ss.
R. E. Hartman (~~employee or owner~~ or (owner or operator) of the above-described well, being first duly sworn on oath, says: That I have knowledge of the facts, statements, and matters herein contained and the log of the above-described well as filed and that the same are true and correct. So help me God.

(Signature) R. E. Hartman
704 Bitting Bldg, Wichita, Kansas
(Address)

SUBSCRIBED AND SWORN TO before me this 11th day of November, 19 63

My commission expires November 28, 1964

Harold H. Pfeiffer
Notary Public.



CERTIFIED DRILLER'S LOG

COMPANY: Lonita Oil Corporation, Inc.
 CONTRACTOR: Lonita Oil Corporation, Inc.
 COMMENCED: October 13, 1963
 COMPLETED: October 31, 1963
 ELEVATION: 2901' R.B.
 LEASE: Garden City A #3
 LOCATION: SE NW SW, 17-22S-33W, Finney County, Kansas
 CASING RECORD: 378' 8-5/8, cem with 275 sacks
 Dry and Abandoned.

<u>FORMATION</u>	<u>DEPTH</u>
Shale and Shells	0 - 1965'
Anyhydrite	1965 - 1990'
Shale and Shells	1990 - 2100'
Shale	2100 - 2503'
Shale and Shells	2503 - 2635'
Lime	2635 - 2782'
Shale and Lime	2782 - 3600'
Lime	3600 - 3801'
Lime and Shale	3801 - 3886'
Lime	3886 - 4016'
Lime with chalk	4016 - 4230'
Lime	4230 - 4870'
RTD	4870'

I hereby certify that this is a true and correct copy of the above log to the best of my knowledge.

R.E. Hartman
 R. E. HARTMAN

STATE OF KANSAS)
) SS
 COUNTY OF SEDGWICK)

Subscribed and sworn to before me this 8th day of November, 1963.

James H. Cooper
 Notary Public

My Commission Expires:
 November 28, 1964

RECEIVED
 STATE CORPORATION COMMISSION

NOV 12 1963

CONSERVATION DIVISION
 Wichita, Kansas

