


WELL PLUGGING RECORD

Give All Information Completely
Make Required Affidavit
Mail or Deliver Report to:
Conservation Division
State Corporation Commission
211 No. Broadway
Wichita, Kansas

NORTH

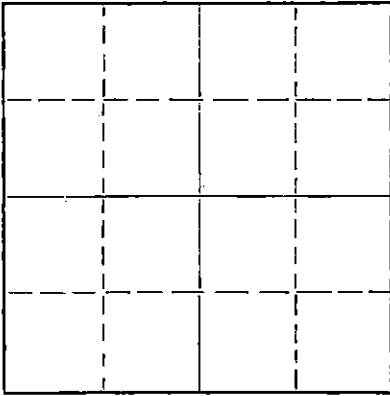

Locate well correctly on above
Section Plat

Finney County. Sec. 18 Twp. 22S Rge. 33W (E) (W)
Location as "NE/CNW/SW" or footage from lines Center SE/4
Lease Owner The Texas Company
Lease Name Garden City Company "D" Unit Well No. 1
Office Address 614 Bitting Building, Wichita, Kansas
Character of Well (completed as Oil, Gas or Dry Hole) Gas
Date well completed April 8 19 54
Application for plugging filed July 26 19 57
Application for plugging approved July 29 19 57
Plugging commenced August 3 19 57
Plugging completed August 4 19 57
Reason for abandonment of well or producing formation Well has never been produced due to high water ratio & low gas production
If a producing well is abandoned, date of last production _____ 19 ____
Was permission obtained from the Conservation Division or its agents before plugging was commenced? Yes

Name of Conservation Agent who supervised plugging of this well M. A. Rives
Producing formation Hugoton Series Depth to top 2528 Bottom 2576 Total Depth of Well 2630 Feet
Show depth and thickness of all water, oil and gas formations. PBD 2570

OIL, GAS OR WATER RECORDS

CASING RECORD

FORMATION	CONTENT	FROM	TO	SIZE	PUT IN	PULLED OUT
				10-3/4"	503'	None
				7"	2633'	25 jts

Describe in detail the manner in which the well was plugged, indicating where the mud fluid was placed and the method or methods used in introducing it into the hole. If cement or other plugs were used, state the character of same and depth placed, from _____ feet to _____ feet for each plug set.

2570' to 2515' - Sand
2515' to 2495' - 5 Sacks Cement
2495' to 400' - Heavy Mud
400' to 390' - Rock Bridge
390' to 335' - 25 Sacks Cement
335' to 30' - Heavy Mud
30' to surface - 10 Sacks Cement

(If additional description is necessary, use BACK of this sheet)
Name of Plugging Contractor R & S Pipe Pulling Company
Address Box 192, Ellinwood, Kansas

STATE OF Kansas, COUNTY OF Sedgwick, ss.
Gene R. Bates (employee of owner) or (owner or operator) of the above-described well, being first duly sworn on oath, says: That I have knowledge of the facts, statements, and matters herein contained and the log of the above-described well as filed and that the same are true and correct. So help me God.

(Signature) Gene R. Bates
614 Bitting Building, Wichita, Kansas
(Address)

SUBSCRIBED AND SWORN TO before me this 6th day of August, 19 57

My commission expires September 20, 1960

H. Howard Kistler
Notary Public.
STATE CORPORATION COMMISSION

PLUGGING
FILE SEC. 18 T. 22 R. 33W
BOOK PAGE 31 LINE 24

8-8-57 AUG 8 1957
CONF. BY THE DIVISION
Wichita, Kansas

LOG OF WELL

FORM PO-214 Sheet 1 (11-93) 25M

GARDEN CITY COMPANY "D" NO. 1

SHEET 1

OWNER The Texas Company DIVISION Oklahoma DATE MADE April 27, 1954
 DISTRICT Kansas LEASE Garden City Company "D" WELL NO. 1
 STATE Kansas COUNTY OR PARISH Finney TWP. 22S RANGE 33W SEC. 18
 LOCATION OF WELL Center of SE/4

COMMENCED RIGGING UP 3-10-54 COMMENCED DRILLING 3-10-54 COMPLETED DRILLING 4-3-54
 DAY DRILLER _____ NIGHT DRILLER _____ CONTRACTOR Stickle Drlg. Co.

CABLE FROM _____ TO _____ ROTARY FROM 0' TO 2630' COMPANY RIO NO. _____

TOTAL DEPTH 2630' MEASURED BY M. G. Harrell ELEVATION KB - 2900
DE - 2897
GL - 2895

PBTD 2596'

CASING RECORD

SIZE	WEIGHT	PUT IN WELL		PULLED OUT		LOST IN WELL		SHOES		PACKERS		
		FEET	INS.	FEET	INS.	FEET	INS.	LENGTH	MARK	KIND	LENGTH	SET AT
<u>10-3/4"</u>	<u>32.75#</u>	<u>503'</u>				<u>(R-2, F-25,</u>		<u>new casing)</u>				<u>FT.</u>
<u>7"</u>	<u>20#</u>	<u>2633'</u>				<u>(R-2, J-55,</u>		<u>new casing)</u>				<u>FT.</u>
												<u>FT.</u>
												<u>FT.</u>
												<u>FT.</u>
												<u>FT.</u>
<u>10-3/4" casing set at 500' with 375 sacks cement, 1% CC. Cement circulated.</u>												<u>FT.</u>
<u>7" casing set at 2629' with 400 sacks cement.</u>												<u>FT.</u>

WAS CASING CEMENTED? _____ IF SO, HOW MANY SACKS OF CEMENT USED? _____
 LINER: STATE SIZE AND WEIGHT _____ WHERE SET _____ FT. AND INS. _____
 BLANK _____ FT. AND INS. _____
 HOW PUT TOGETHER _____ COUPLING _____ FLUSH-JOINT _____ INSERTED _____
 REMARKS: _____

EQUIPMENT RECORD

TUBING				SUCKER RODS			PUMPING OUTFIT
SIZE	WEIGHT	FEET	INS.	FEET	INS.	SIZE AND KIND	DESCRIPTION, KIND, SIZE, ETC.

Completed Testing 4-8-54

FLOWING, PUMPING, GASSER OR DRY Gasser PRODUCTION FIRST 24 HOURS 72/20 Test, 400 MCECPD
 IF GAS WELL, OPEN FLOW CAPACITY _____ SHUT IN PRESSURE _____ ROCK PRESSURE _____
 KIND OF SHOT _____ SIZE OF SHOT, QUARTS _____
 NUMBER OF SHELLS _____ SIZE OF SHELLS _____ INCHES, DIAMETER _____
 LENGTH OF SHELLS _____ FEET _____ INCHES _____ TOP OF SHOT _____
 BOTTOM OF SHOT _____ ANCHOR _____ WELL BRIDGED TO _____
 TOTAL DEPTH OF WELL _____ NUMBER OF SHOT _____ PRODUCTION BEFORE SHOT _____ BBLs PER DAY _____
 PRODUCTION AFTER SHOT _____ BBLs, PER DAY. SHOT FURNISHED BY _____
 NAME OF SHOOTER _____ SHOT INSPECTED _____ BY _____ (COMPANY EMPLOYEE)
 COMMENCED DRILLING DEEPER _____ COMPLETED _____ DRILLING DEEPER _____
 TOTAL DEPTH _____ PRODUCTION FIRST 24 HOURS _____ PRODUCTION SETTLED _____

REMARKS: _____
Garden City Company "D" #1
Hugoton Pool
TD 2630' - PBTD 2596'
Completed Drilling 3-29-54
Completed Testing 4-8-54

NOTE: IF WELL WAS DRY, STATE UNDER REMARKS, WHEN, HOW, AND BY WHOM PLUGGED.
 STATE UNDER REMARKS ANYTHING OF INTEREST NOT COVERED IN LOG.
 IF THE SPACE PROVIDED FOR REMARKS IS NOT SUFFICIENT WRITE ON BOTTOM OF LAST SHEET OF LOG.

\$3.40 - \$550 - \$500

PLUGGING

FILE SEC 18 T. 22 R. 33W

BOOK, PAGE 31 LINE 24

TOTAL NUMBER OF SHEETS _____

The Texas Company
Tulsa, Oklahoma

Tulsa, Oklahoma
March 17, 1954

CONTRACTOR: Stickle Drilling Company
Drilling Commenced: March 10, 1954
Drilling Completed: March 15, 1954

Garden City Co "D" #1
C of SE/4 Section 18-22S-
33W, Finney County, Kansas.

DRILLERS LOG

Sand & Red Bed
Shale & Shells
Shale & Lime
Lime & Shale

0-150
150-2255
2255-2479
2479-2630 TD

I, Frank E. Stickle hereby certify the above to be a true and complete Drillers Log of the Texas Company's Garden City Company "D" #1 C of SE/4 Section 18-22S-33W, Finney County, Kansas.

Frank E. Stickle
Frank E. Stickle

Lillian T. Bonham

Notary Public

February 13, 1956

My Commission Expires

RECEIVED
STATE OF KANSAS

PLUGGING CO
FILE SEC 18 T 22 R 33W
BOOK PAGE 31 LINE 24

AUG 1956
DIVISION