


Give All Information Completely  
Make Required Affidavit  
Mail or Deliver Report to:  
Conservation Division  
State Corporation Commission  
211 No. Broadway  
Wichita, Kansas

WELL PLUGGING RECORD

Finney County, Sec 22 Twp. 22S Rge. 33W (E) (W)  
Location as "NE/CNW/SW" or footage from lines Ctr. SW NW  
Lease Owner Texaco Inc.  
Lease Name O. J. Walters B Well No. 1  
Office Address 614 Bitting Bldg., Wichita, Kansas  
Character of Well (completed as Oil, Gas or Dry Hole) Dry Hole  
Date well completed 12-7- 1960  
Application for plugging filed 12-10- 1962  
Application for plugging approved 12-11- 1962  
Plugging commenced 12-30 1962  
Plugging completed 1-1- 1963  
Reason for abandonment of well or producing formation Dry Hole

NORTH

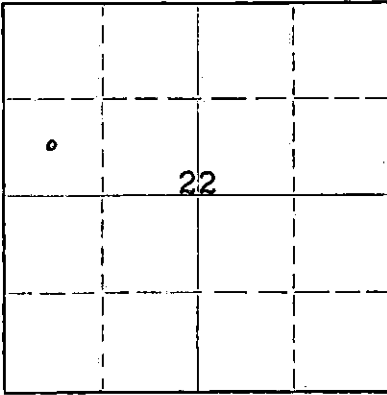

Locate well correctly on above  
Section Plat

If a producing well is abandoned, date of last production \_\_\_\_\_ 19\_\_\_\_  
Was permission obtained from the Conservation Division or its agents before plugging was commenced? Yes

Name of Conservation Agent who supervised plugging of this well Hugh Scott  
Producing formation Dry Hole Depth to top \_\_\_\_\_ Bottom \_\_\_\_\_ Total Depth of Well 4800 Feet  
Show depth and thickness of all water, oil and gas formations.

OIL, GAS OR WATER RECORDS

CASING RECORD

FORMATION	CONTENT	FROM	TO	SIZE	PUT IN	PULLED OUT
Mississippian	Salt Water	4652	4725	8-5/8"	405	None
				4-1/2"	4808	2980

Describe in detail the manner in which the well was plugged, indicating where the mud fluid was placed and the method or methods used in introducing it into the hole. If cement or other plugs were used, state the character of same and depth placed, from \_\_\_\_\_ feet to \_\_\_\_\_ feet for each plug set.

Hole plugged as follows: Plugged back 4760-4700 w/sand, 4760-4667 3 sacks cement, 4667-375 heavy mud, 375-360 rock bridge, 360-262 35 sacks cement, 262-50 heavy mud, 50' - 40' rock bridge, 40'-3' 15 sacks cement.

RECEIVED  
STATE CORPORATION COMMISSION

JAN 10 1963

CONSERVATION DIVISION  
Wichita, Kansas

(If additional description is necessary, use BACK of this sheet)

Name of Plugging Contractor Knight Casing Pulling Company  
Address Box 304 Chase, Kansas

STATE OF Kansas, COUNTY OF Sedgwick, ss.  
F. E. Anderson (employee of owner) or ~~Notary Public~~ of the above-described well, being first duly sworn on oath, says: That I have knowledge of the facts, statements, and matters herein contained and the log of the above-described well as filed and that the same are true and correct. So help me God.

(Signature) F. E. Anderson Ass't. Dist. Supt.  
614 Bitting Bldg., Wichita, Kansas  
(Address)

SUBSCRIBED AND SWORN TO before me this 3rd day of January, 19 63

My commission expires April 1, 1963

Jula J. Card  
Notary Public.



# WELL LOG

COMPANY **TEXACO, INCORPORATED**

SEC. **22 T22S R. 33W**

FARM **O. J. WALTERS "B" NO. 1**

LOC. **C-SW, NW**

TOTAL DEPTH **4800'**

COUNTY **FINNEY CO., KANSAS**

COMM. **November 10, 1960** COMP. **November 23, 1960**

CONTRACTOR **GARVEY DRILLING COMPANY**



CASING **8 5/8" @ 397' w/300 sax.  
4 1/2" @ 4800' w/125 sax.**

ELEVATION

PRODUCTION

FIGURES INDICATE BOTTOM OF FORMATIONS

145	Clay
210	Clay & sand
612	Shale
985	Blue & gray shale
1342	Red bed
1370	Anhydrite
1415	Shale & shells.
1565	Shale
1700	Sand
1950	Red bed & shale
2000	Lime & shale
2315	Shale & lime
2520	Shale, shells & lime
3025	Lime & shale
3060	Lime
3085	Lime & shale
3400	Lime w/shale streaks
3780	Chalky lime
3835	Shale & lime
4250	Lime
4408	Lime & shale
4430	Shale & lime
4460	Lime & shale
4606	Lime
4663	Lime, shale & sand
4800	Lime
4800	T. D.

RECORDED  
INDEXED  
NOV 23 1960  
GARVEY DRILLING COMPANY

State of KANSAS

County of BARTON

I, VERNE A. MORRIS

of GARVEY DRILLING COMPANY

upon oath state that the above and foregoing is a true and correct copy of the log of the #1 WALTERS "B" well

*Verne A. Morris*

Subscribed and sworn to before me this 2nd day of December 19 60

My Commission Expires: November 12, 1962

*Stanbury*  
NOTARY PUBLIC

File

15-055-10171-0000

FORM PO-214 SHEET 1 (7-59) 10M

TEXACO INC.—LOG OF WELL  
TULSA DIVISION

640 ACRES  
N


INDICATE EXACT WELL LOCATION & LEASE BOUNDARY WITHIN SECTION

WELL O. J. Walters #1 #1 L. D. FILE NO. 121925

LOC. Qtr. SW NW SEC. 22 TWP. 22S RGE. 33W

660' E & 660' N of SW Cor of NW/4

DIST. Wichita CO.-PARISH Finney STATE Kansas

COMM. DRG. November 10-'60 COMP. DRG. November 23, '60 DAYS DRG. 14

ROT. FROM 0 TO 4800' CABLE FROM - TO -

CONTR. OR CO. RIG NO. Garvey Drilling T. D. DRILLED 4800

COMP. T. D. PE 4762 ZERO ELEV. - GRD. ELEV. 2678' CGG. FLG. ELEV. KB-GL 9'  
GL-BH 0'

DATE OF FIRST PROD. Dry Hole OFFICIAL COMP. DATE 12-7-60

LOGS RUN Induction - Electric

CASING RECORD

SIZE INCHES	DEPTH FEET	WEIGHT #/FT.	GRADE	RANGE	REMARKS—QUAN. CMT., TEMP. SURV., ETC.
8-5/8	405	22.7	SW	3	Set & Cmtd @ 397' w/300 Sx Pos, 2% C.C. Cmt Circ.
4-1/2	4808	9.5	J	2	Set & Cmtd @ 4800' w/125 Sx Pos.
					CENTRALIZERS: 3 from 4650 to 4710'
					SCRATCHERS: 9 from 4660 to 4742

COMPLETION DATA

FORMATION	<u>Morrow</u>			
DATE OF TEST	<u>Dry hole</u>			
DEPTH OF PROD. INTERVAL				
INITIAL PRODUCTION:				
OIL - BPD				cc: No well log Index Index } 12/79
GAS - MCF				
WATER - BPD				
GOR				
BHP - PSI				
CORRECTED API GRAVITY				
PRODUCING CONDITIONS				
ARTIFICIAL STIMULATION				

REMARKS

1) 3.30  
2) 875.00  
#525.00  
#475.00

WELL O. J. Walters #1 #1 FIELD Danns AREA Liberal