


**WELL PLUGGING RECORD**

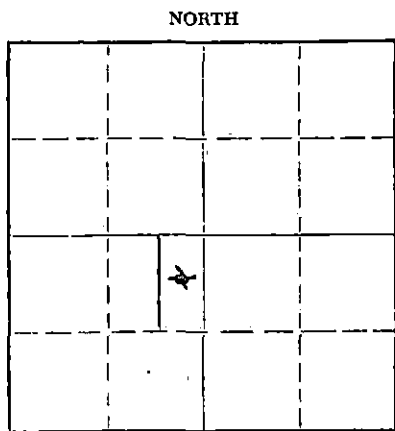

Locate well correctly on above Section Plat

Kearney County. Sec. 23 Twp. 22 Rge. 38 (E) W (W)  
 Location as "NE/CNW/SW" or footage from lines C of E/2 NE SW  
 Lease Owner W. B. Osborn  
 Lease Name Patterson Well No. 1  
 Office Address P. O. Box 6767, San Antonio 9, Texas  
 Character of Well (completed as Oil, Gas or Dry Hole) Dry Hole  
 Date well completed Drilling completed 12-22 1962  
 Application for plugging filed By phone 12-22- 1962  
 Application for plugging approved By phone 12-22- 1962  
 Plugging commenced 12-23- 1962  
 Plugging completed 12-23- 1962  
 Reason for abandonment of well or producing formation No producing formation found.  
 If a producing well is abandoned, date of last production None 19     
 Was permission obtained from the Conservation Division or its agents before plugging was commenced? Yes

Name of Conservation Agent who supervised plugging of this well Agent in Liberal, Kansas  
 Producing formation None Depth to top     Bottom     Total Depth of Well 4880 Feet  
 Show depth and thickness of all water, oil and gas formations.

**OIL, GAS OR WATER RECORDS**

**CASING RECORD**

FORMATION	CONTENT	FROM	TO	SIZE	PUT IN	PULLED OUT
Surface Sands	Water	0	700'	8-5/8	1212'	0

Describe in detail the manner in which the well was plugged, indicating where the mud fluid was placed and the method or methods used in introducing it into the hole. If cement or other plugs were used, state the character of same and depth placed, from     feet to     feet for each plug set.

Hole left full of 9.9#/gal. rotary mud. 35 sx. cement plug was spotted by Halliburton pump truck thru open end drill pipe from 750 ft. back to 650 ft. Then 15 sx. plug of cement was placed from 45 ft. back to bottom of cellar.

RECEIVED  
 STATE CORPORATION COMMISSION

JAN 2 1963

CONSERVATION DIVISION  
 Wichita, Kansas

(If additional description is necessary, use BACK of this sheet)  
 Name of Plugging Contractor Plugged by drilling contractor - Garvey Drilling Co.  
 Address Great Bend, Kansas

STATE OF Texas, COUNTY OF Bexar, ss.  
Jack Watson, Jr. (employee of owner) or (under contract) of the above-described well, being first duly sworn on oath, says: That I have knowledge of the facts, statements, and matters herein contained and the log of the above-described well as filed and that the same are true and correct. So help me God.

(Signature) Jack Watson, Jr.  
Jack Watson, Jr.  
P.O. Box 6767, San Antonio, Texas  
 (Address)

SUBSCRIBED AND SWORN TO before me this 31st day of December, 19 62

My commission expires 6-1-63  
Doris I. Harper Notary Public.

