

15-075-20196-00-00

STATE OF KANSAS
STATE CORPORATION COMMISSION

WELL PLUGGING RECORD

Give All Information Completely
Make Required Affidavit
Mail or Deliver Report to
Conservation Division
State Corporation Comm.
245 North Water
Wichita, KS 67202

Hamilton County. Sec. 35 Twp. 23 Rge. 39 E/W
Location as "NE/CNW $\frac{1}{4}$ SW $\frac{1}{4}$ " or footage from lines
1320' FSL & 660' FWL

Lease Owner American Public Energy Company
Lease Name McNeill Well No. 1

Office Address 744 Campbell Centre, Dallas, Texas 75206

Character of Well (Completed as Oil, Gas or Dry Hole) _____

Gas

Date Well completed _____ 19 _____

Application for plugging filed 8-30 _____ 1978

Application for plugging approved 9-1 _____ 1978

Plugging commenced 9-4 _____ 1978

Plugging completed 9-5 _____ 1978


Reason for abandonment of well or producing formation _____

Non Commercial Value

If a producing well is abandoned, date of last production _____ 19 _____

No production

Was permission obtained from the Conservation Division or its agents before plugging was commenced? Yes

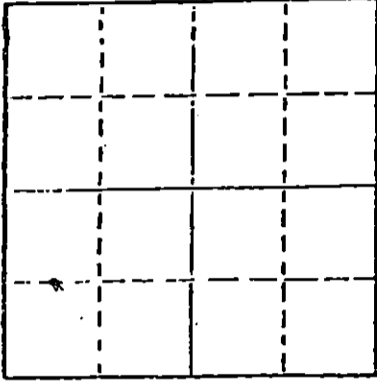

Locate well correctly on above Section Plat

Name of Conservation Agent who supervised plugging of this well Mr. Thomas

Producing formation Hugoton Depth to top 2564' Bottom 2570' Total Depth of Well 3050'

Show depth and thickness of all water, oil and gas formations.

OIL, GAS OR WATER RECORDS

CASING RECORD

FORMATION	CONTENT	FROM	TO	SIZE	PUT IN	PULLED OUT
Surface				8 5/8"	337'	0'
Production				4 1/2"	3029'	45'

Describe in detail the manner in which the well was plugged, indicating where the mud fluid was placed and the method or methods used in introducing it into the hold. If cement or other plugs were used, state the character of same and depth placed, from _____ feet to _____ feet for each plug set.

Pumped 1 Sacks hulls & 10 sacks cement to 2450' & pressured to 750 lbs.

Displaced to 330'

Pumped 10 sacks cement 330' to 210'

Displaced to 40'

Put bridge & 10 sacks cement 40' to 0'

Cut off 8 5/8" 42" below ground level.

RECEIVED
STATE CORPORATION COMMISSION

JAN 12 1979

(If additional description is necessary, use BACKWICH sheet)

Name of Plugging Contractor Midwest Casing Pulling

Box F, Sublette, Kansas 67877 Permit # 766

STATE OF KANSAS COUNTY OF Haskell, ss.

I Edgar J. Eves (employee of owner) or (owner or operator)

of the above-described well, being first duly sworn on oath, says: That I have knowledge of the facts, statements, and matters herein contained and the log of the above-described well as filed and that the same are true and correct. So help me God.

(Signature)

Edgar J. Eves
Box F, Sublette, Kansas 67877

(Address)

SUBSCRIBED AND SWORN TO before me this 7th day of September, 19 78

London J. Eves

Notary Public.

My commission expires 12-6-80

SEP 20 1978

