


WELL PLUGGING RECORD

Give All Information Completely
Make Required Affidavit
Mail or Deliver Report to:
Conservation Division
State Corporation Commission
800 Bitting Building
Wichita, Kansas

Barton County. Sec. 25 Twp. 16 Rge. 11 (E) 11 (W)

Location as "NE/CNW $\frac{1}{4}$ SW $\frac{1}{4}$ " or footage from lines NW NW SW
Lease Owner Murfin & Aledo
Lease Name Breford Well No. 1
Office Address Un. Natl. Bank Bldg., Wichita, Ks.
Character of Well (completed as Oil, Gas or Dry Hole) Dry Hole
Date well completed 5-5-52 19
Application for plugging filed 5-5-52 19
Application for plugging approved 5-5-52 19
Plugging commenced 5-5-52 19
Plugging completed 5-5-52 19
Reason for abandonment of well or producing formation

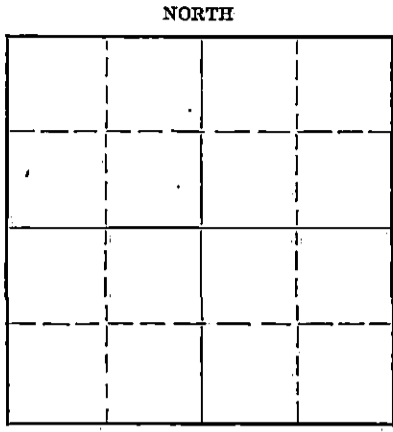

Locate well correctly on above Section Plat

If a producing well is abandoned, date of last production 19
Was permission obtained from the Conservation Division or its agents before plugging was commenced? Yes

Name of Conservation Agent who supervised plugging of this well C. D. Stough
Producing formation Depth to top Bottom Total Depth of Well 3405 Feet
Show depth and thickness of all water, oil and gas formations.

OIL, GAS OR WATER RECORDS

CASING RECORD

Formation	Content	From	To	Size	Put In	Pulled Out
				8 5/8	295	0

Describe in detail the manner in which the well was plugged, indicating where the mud fluid was placed and the method or methods used in introducing it into the hole. If cement or other plugs were used, state the character of same and depth placed, from feet to feet for each plug set.

Set first plug @ 275'. Mixed and displaced 20 sacks cement through drill pipe. Set 2nd plug, mixed and displaced 10 sacks cement to surface.

(If additional description is necessary, use BACK of this sheet)

Name of Plugging Contractor Murfin Drilling Co.
Address 910 Union Natl. Bank Bldg., Wichita, Ks.

STATE OF Kansas, COUNTY OF Sedgwick, ss.
W. R. Murfin (employee of owner) or (owner or operator) of the above-described well,
being first duly sworn on oath, says: That I have knowledge of the facts, statements, and matters herein contained and the log of the above-described well as filed and that the same are true and correct. So help me God.

(Signature) *W R Murfin*
Wichita, Ks.
(Address)

SUBSCRIBED AND SWORN to before me this 14th day of May, 19 52
Helen [Signature]
Notary Public.

My commission expires 6-4-55

23-8390-s 6-51-20M

PLUGGING
FILE SEC 25 T 16 R 11 W
BOOK PAGE 14 LINE 7

RECEIVED
MAY 15 1952
5-15-52
CONSERVATION DIVISION
Wichita, Kansas

WELL LOG

15009-001900000

COMPANY Murfin & Aledo

SEC. 25 T. 16 R. 11W

FARM Breford

NO. 1

LOG. NW NW SW

TOTAL DEPTH 3405

COUNTY Barton

DDMM. 4-25-52


DDMM. 5-5-52

KANSAS

SHOT OR TREATED

CONTRACTOR Murfin Drilling Co.

ISSUED

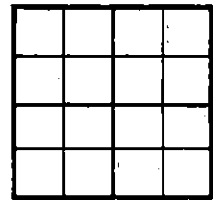

CASING

20	10
15	8 275
12	6
13	5

ELEVATION 1897 DF

PRODUCTION Dry

FIGURES INDICATE BOTTOM OF FORMATIONS

100 clay & sand stone
 495 clay-shells
 702 red bed
 725 Anhydrite
 1020 shale-shells
 1295 salt-shells
 1405 shale-shells
 1635 lime-shale
 1800 lime
 1885 lime-shale
 2855 lime-shale
 2980 lime
 3040 lime-shale
 3405 lime

Tops

Heebner	2933
Dodge	2951
Brown Lime0	3035
Lansing	3051
Congl.	3346
Arb.	3372
T.D.	3405

RECEIVED
 STATE CORPORATION COMMISSION
 MAY 15 1952
 CONSERVATION DIVISION
 Wichita, Kansas

State of Kansas }
 County of Sedgwick } ss:

I, W. R. Murfin of the Murfin Drilling Company

upon oath state that the above and foregoing is a true and correct copy of the log of the Breford #1 well:

W.R. Murfin

Subscribed and sworn to before me this 14th day of May 1952

My Commission Expires: 6-4-55

PLUGGING
 FILE SEC 25 T 16 R 11W
 BOOK PAGE 14 LINE 17

NOTARY PUBLIC

Steven Horine