


Give All Information Completely
Make Required Affidavit
Mail or Deliver Report to:
Conservation Division
State Corporation Commission
212 North Market, Insurance Bldg.
Wichita, Kansas

WELL PLUGGING RECORD

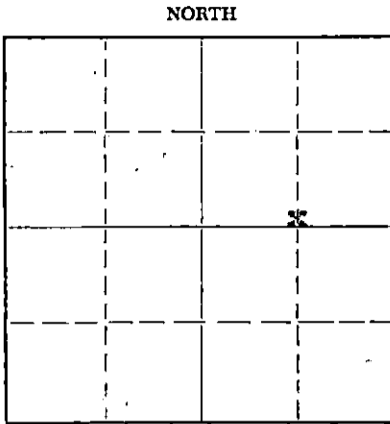

Finney County, Sec. 32 Twp. 22 Rge. 31 (E) W (W)
Location as "NE/CNW/SW" or footage from lines C E/2
Lease Owner J. E. Newman and Ferguson Investment Company
Lease Name Lewis Well No. 1
Office Address Denver, Colorado
Character of Well (completed as Oil, Gas or Dry Hole) Dry Hole
Date well completed June 29 19 60
Application for plugging filed June 29 19 60
Application for plugging approved June 29 19 60
Plugging commenced July 1 19 60
Plugging completed 9:00 a.m. July 2 19 60
Reason for abandonment of well or producing formation Non Productive

If a producing well is abandoned, date of last production _____ 19 ____
Was permission obtained from the Conservation Division or its agents before plugging was commenced? YES

Name of Conservation Agent who supervised plugging of this well W. L. Lac Kamp
Producing formation None Depth to top _____ Bottom _____ Total Depth of Well 2848 Feet
Show depth and thickness of all water, oil and gas formations.

OIL, GAS OR WATER RECORDS

CASING RECORD

FORMATION	CONTENT	FROM	TO	SIZE	PUT IN	PULLED OUT
<u>Hemington</u>	<u>water</u>	<u>2677</u>	<u>2686</u>	<u>8 5/8</u>	<u>385</u>	<u>None</u>
<u>Kirder</u>	<u>water</u>	<u>2704</u>	<u>2730</u>	<u>4 1/2</u>	<u>2847</u>	<u>1200'</u>

Describe in detail the manner in which the well was plugged, indicating where the mud fluid was placed and the method or methods used in introducing it into the hole. If cement or other plugs were used, state the character of same and depth placed, from _____ feet to _____ feet for each plug set.

Plug with cement 2670' - 2730'.
Mudded up to 280'.
Pushed Halliburton plug to 280'.
Bridged with rock to 270'.
Plug with cement to 170'.
Mudded up to 40'.
Pushed Halliburton plug to 40'.
Bridged with rock to 30'.
Plug with cement to bottom of celler.

RECEIVED
STATE CORPORATION COMMISSION

JUL 13 1960

CONSERVATION DIVISION
Wichita, Kansas

(If additional description is necessary, use BACK of this sheet)
Name of Plugging Contractor Cherokee Drilling Company
Address El Dorado, Kansas

STATE OF Kansas, COUNTY OF Finney, ss.
R. W. Lange, employee of owner (employee of owner) or (owner or operator) of the above-described well, being first duly sworn on oath, says: That I have knowledge of the facts, statements, and matters herein contained and the log of the above-described well as filed and that the same are true and correct. So help me God.

(Signature) R. W. Lange
Garden City, Kansas
(Address)

SUBSCRIBED AND SWORN TO before me this 12 day of July, 19 60

My commission expires 7 Nov 1, 60 Notary Public.



15-655-00221-0000

WELL LOG BUREAU—KANSAS GEOLOGICAL SOCIETY
508 East Murdock, Wichita, Kansas


COPY

Company- J. E. NEWMAN
Farm- Lewis No. 1

SEC. 32 T. 22 R.31W
C W/2 E/2

Total Depth. 2800'
Comm. 10-1-60 Comp. 10-28-60
Shot or Treated.
Contractor. Cherokee Drlg. & Explor.
Issued. 6-10-61

County Finney
KANSAS

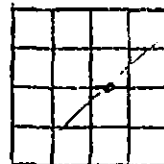

CASING:
8" 385'
4" 2847'

Elevation. ??

Production. Dry

Figures indicate Bottom of Formations.

COMPLETE DRILLERS LOG NOT AVAILABLE:

TOPS: SCOUT
Herrington 2677
Krider 2704
Total Depth 2800