

STATE OF KANSAS  
STATE CORPORATION COMMISSION

WELL PLUGGING RECORD

Give All Information Completely  
Make Required Affidavit  
Mail or Deliver Report to  
Conservation Division  
State Corporation Comm.  
245 North Water  
Wichita, KS 67202

Hamilton County, Sec. 10 Twp. 22S Rge. 42 E/W  
Location as "NE/CNW $\frac{1}{2}$ /SW $\frac{1}{2}$ " or footage from lines \_\_\_\_\_  
C/NW/SE

Lease Owner Dome Petroleum Corp.

Lease Name Cheatum Well No. #2

Office Address \_\_\_\_\_

Character of Well (Completed as Oil, Gas or Dry Hole) \_\_\_\_\_

Date Well completed \_\_\_\_\_ 19\_\_

Application for plugging filed \_\_\_\_\_ 19\_\_

Application for plugging approved \_\_\_\_\_ 19\_\_

Plugging commenced \_\_\_\_\_ 12-16 1980


Plugging completed \_\_\_\_\_ 1-14 1981

Reason for abandonment of well or producing formation \_\_\_\_\_

Non Commercial value

If a producing well is abandoned, date of last production \_\_\_\_\_ 19\_\_

Was permission obtained from the Conservation Division or its agents before plugging was commenced? Yes

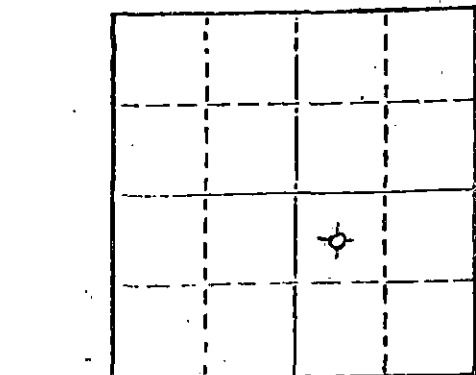

Locate well correctly on above Section Plot

Name of Conservation Agent who supervised plugging of this well Mr. Thomas  
Producing formation Winfield Depth to top 2630 Bottom 2646 Total Depth of Well 2743

Show depth and thickness of all water, oil and gas formations.

OIL, GAS OR WATER RECORDS

CASING RECORD

FORMATION	CONTENT	FROM	TO	SIZE	PUT IN	PULLED OUT
Surface				8-5/8"	363	0
Production				4.5"	2735	0

Describe in detail the manner in which the well was plugged, indicating where the mud fluid was placed and the method or methods used in introducing it into the hold. If cement or other plugs were used, state the character of same and depth placed, from \_\_\_\_\_ feet to \_\_\_\_\_ feet for each plug set.

12-16-80 Pumped 2 sx. hulls and 50 sx. cement. Displaced to bottom with 9#/gal. gelled water and 10 sx. cement for top plug. Pressured up to 500#.

12-22-80 Pumped 4 sx. cement

1-13-81 Drilled out top plug. Tagged bottom plug @1850'.

1-14-81 Set Halco cement retainer at 1500'. Pumped 10 sx. cement on top. Pulled tubing up to 350'. Set 30 sx. cement plug to surface. Cut off 8-5/8" & 4 1/2" casings 48" below ground level.

(If additional description is necessary, use BACK of this sheet)

Name of Plugging Contractor Halliburton Lamar, Colorado

STATE OF Colorado COUNTY OF Denver, ss.  
Jerry Anderson (employee of owner) or (owner or operator)  
of the above-described well, being first duly sworn on oath, says: That I have knowledge of the facts, statements, and matters herein contained and the log of the above-described well as filed and that the same are true and correct. So help me God.

(Signature) Jerry Anderson  
1625 Broadway Ste 2900 Denver, Co. 80202  
(Address)

SUBSCRIBED AND SWORN TO before me this 22nd day of January, 1981

My commission expires August 16, 1981

[Signature]  
Wichita, Notary Public.

2-5-81

15-075-20242-0000

Height of LOCATION WELL

COMPANY

COMPANY DOME PETROLEUM CORP.

WELL CHEATUM #2

FIELD BRADSHAW

COUNTY HAMILTON STATE KANSAS

LOCATION API Serial No. \_\_\_\_\_ Other Services:  
CNW SE  
 Sec. 10 Twp. 22 S Rge. 42 W TOT-K

Reference Datum: GROUND, Elev. \_\_\_\_\_ Elev.: K.B. 3623  
 Measured From KB, 2 Ft. Above Perm. Datum D.F. \_\_\_\_\_  
 Measured From KB G.L. 3618

No.	<u>6-13-78</u>		Casing Fluid	<u>WATER</u>		
Driller	<u>ONE</u>		Fluid Level	<u>FULL</u>		
Logger	<u>2693</u>		Max. Rec. Temp.	<u>N.A.</u> °F		
Log Interval	<u>2685</u>		Est. Cement Top	<u>735</u>		
Log Interval	<u>2674</u>		Unit	<u>5715</u>	<u>WNCH</u>	
Hole Size	<u>7 7/8</u>		Recorded By	<u>BATCHELLER</u>		
LOG REC.			Witnessed By	<u>JOHNSON</u>		
Casing String	Size <u>8 5/8</u>	Wt/Ft	Grade	Type	Joint	Top Bottom
String						<u>GL 350</u>
String	<u>4 1/2</u>					<u>GL 50</u>

PRIMARY CEMENTING DATA

LOG	Surface	Protection	Production	Liner
of cement				
of cement				
itive				
Order			<u>DEC 5 1980</u>	
of slurry				
ter loss				
e-fluid in csg.				
d wt.				

CONSERVATION DIVISION  
Wichita, Kansas

The well name, location and borehole reference data were furnished by the customer.

