


STATE OF KANSAS  
STATE CORPORATION COMMISSION

WELL PLUGGING RECORD

Give All Information Completely  
Make Required Affidavit  
Mail or Deliver Report to  
Conservation Division  
State Corporation Comm.  
245 North Water  
Wichita, KS 67202

Finney County, Sec. 1 Twp. 22S Rge. 33 ~~W~~  
Location as "NE/CNW $\frac{1}{4}$ SW $\frac{1}{4}$ " or footage from lines  
C of Sec. 1

Lease Owner Texaco Inc.  
Lease Name Kisner-Blöedel Well No. 1  
Office Address Box 2420, Tulsa, OK 74102  
Character of Well (Completed as Oil, Gas or Dry Hole) Gas

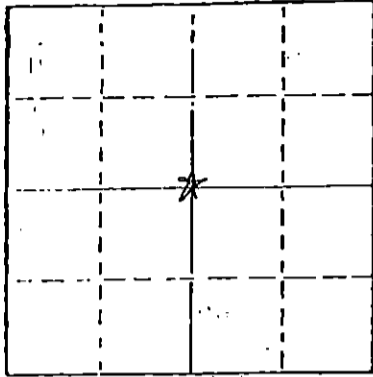

Locate well correctly on above Section Plot Sec. 1

Date Well completed 6/24 1978  
Application for plugging filed 5/8 1978  
Application for plugging approved 5/15 1978  
Plugging commenced 5/31 1978  
Plugging completed 6/1 1978  
Reason for abandonment of well or producing formation Not needed

If a producing well is abandoned, date of last production N/A 1978

Was permission obtained from the Conservation Division or its agents before plugging was commenced? Yes

Name of Conservation Agent who supervised plugging of this well Clarence Thomas  
Producing formation \_\_\_\_\_ Depth to top \_\_\_\_\_ Bottom \_\_\_\_\_ Total Depth of Well 2675'  
Show depth and thickness of all water, oil and gas formations.

OIL, GAS OR WATER RECORDS

CASING RECORD

FORMER RECORDS	CONTENT	FROM	TO	SIZE	PUT IN	PULLED OUT

Describe in detail the manner in which the well was plugged, indicating where the mud fluid was placed and the method or methods used in introducing it into the hold. If cement or other plugs were used, state the character of same and depth placed, from \_\_\_\_\_ feet to \_\_\_\_\_ feet for each plug set.

Well plugged from 2675-2500' w/20 sx, 2500-400' w/hvy mud,  
400-300' w/50 sx cmt, 300-40' w/hvy mud & from 40' to surf  
w/10 sx cmt.

(If additional description is necessary, use BACK of this sheet)

Name of Plugging Contractor Sargents Casing Pulling Service

STATE OF OKLAHOMA COUNTY OF TULSA, ss.  
R. W. Lovell (employee of owner) or ~~known contractor~~

of the above-described well, being first duly sworn on oath, says: That I have knowledge of the facts, statements, and matters herein contained and the log of the above-described well as filed and that the same are true and correct. So help me God.

(Signature) R. W. Lovell R. W. LOVELL  
p. O. Box 2420, Tulsa, OK 74102  
(Address)

SUBSCRIBED AND SWORN TO before me this 8th day of June, 1978.

Elizabeth A. Legg  
Notary Public.

My commission expires July 21, 1979

W E L L \* L O G

Kisner-Blodel #1 in Section 1-22-33 Finney  
County, Kansas.

5-28-56 Rigging up-spud led in 2:30 P. M.  
0' to 150' Clay  
150' to 275' Sand & Shale  
275' to 495' Blue Shale  
5-29-56 495' to 520' Blue Shale  
520' TD Surface Hole  
Run 13 Jts. 8-5/8" OD Slip Jt. Spiral Weld Casing  
set at 515' Cemented with 350 ex Poznix cement  
2% Calcium chloride stopped plug @ 475' Plug down  
5:00 A.M. cement circulated waiting on cement  
5-30-56 520' to 660' Blue Shale & Gyp  
660' to 1050' Blue Shale  
1050' to 1325' Red Bed  
3-31-56 1325' to 1398' Lost Circulation 1:00 A.M.  
1398' to 1429' Mixed Mud-got returns drilled at 3:00  
A.M. Made trip No returns Mixing mud  
1429' to 1600' Shale  
1600' to 1642' Salt Got returns back at 3:00 P.M.  
3:00 P.M. to 5:30 P.M. Drilling 5:30 P.M. to 6:30 P.M.  
Mixing Mud 6:30 P.M. til 9:00 P.M. Drilling  
9:00 P.M. til 10:00 P.M. mixing mud drilling til  
12:00 Midnight  
6-1-56 1642' to 1958' Red Shale Gype Mixing Mud  
1958' to 2050' Shale  
2050' to 2188' Lime & Shale  
6-2-56 2188' to 2340' Shale & Lime Mixing Mud  
2340' to 2425' Lime & Shale Mixing Mud  
6-3-56 2425' to 2520' Lime & Shale Mixing Mud  
2520' to 2581' Lime Mixing Mud  
2581' to 2646' Shale & Lime Mixing Mud -- Put in 40 bbls.  
Diesel Fuel.  
6-4-56 2646' to 2675' Lime TD  
Running Log  
Run 84 jts 5 1/2" od 8 rd thd new smls casing  
2675.42' set at 2671' stopped plug at 2634'  
Plug down at 5:30 P.M. Cement did not circulate

RECEIVED  
STATE CORPORATION COMMISSION

MAY 15 1978

CONSERVATION DIVISION  
Wichita, Kansas

RECD

MAY 15 1978

WICHITA, KANSAS