


STATE OF KANSAS  
STATE CORPORATION COMMISSION

Form CP-4

Give All Information Completely  
Make Required Affidavit  
Mail or Deliver Report to:  
Conservation Division  
State Corporation Commission  
P. O. Box 17027  
Wichita, Kansas 67217  
NORTH

WELL PLUGGING RECORD

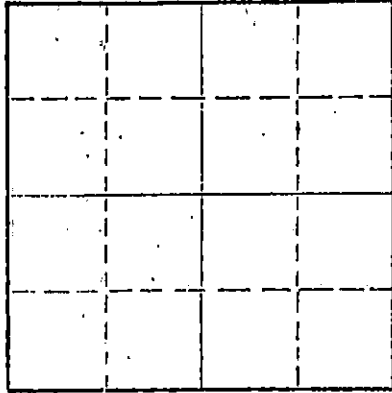

Locate well correctly on above  
Section Plat

Finney County, Sec 4 Twp 22S. Rge. (E) 33W(W)  
Location as "NE/CNW/SW" or footage from lines SE NW NW  
Lease Owner W. L. Hartman  
Lease Name Wilson Well No. 1  
Office Address P. O. Box 54, Wichita, Kansas 67201  
Character of Well (completed as Oil, Gas or Dry Hole) Dry Hole  
Date well completed October 6, 19 73  
Application for plugging filed 19  
Application for plugging approved 19  
Plugging commenced October 6, 19 73  
Plugging completed October 6, 19 73  
Reason for abandonment of well or producing formation Dry Hole

If a producing well is abandoned, date of last production 19  
Was permission obtained from the Conservation Division or its agents before plugging was commenced? Yes (Edgar Eves of Sublette)

Name of Conservation Agent who supervised plugging of this well  
Producing formation Depth to top Bottom Total Depth of Well 4835 Feet  
Show depth and thickness of all water, oil and gas formations.

OIL, GAS OR WATER RECORDS

CASING RECORD

FORMATION	CONTENT	FROM	TO	SIZE	PUT IN	PULLED OUT
	Surface	0	448'	8-5/8"	448'	None
	Casing					

Describe in detail the manner in which the well was plugged, indicating where the mud fluid was placed and the method or methods used in introducing it into the hole. If cement or other plugs were used, state the character of same and depth placed, from feet to feet for each plug set.

Heavy Mud from Total Depth to 2650 Feet,  
50 sax Cement Plug; Mud to 450 Feet, 40  
sax Cement Plug; Mud to 40 Feet, 1/2 sax  
Hulls, Plug Bridged & 10 sax Cement to  
Base of Cellar. Job Completed @ 12:30 P.M.

RECEIVED  
STATE CORPORATION COMMISSION  
OCT 12 1973  
CONSERVATION DIVISION  
Wichita, Kansas

Name of Plugging Contractor Allied Cementing Co., Inc.  
Address Box 207, Russell, Kansas

STATE OF KANSAS COUNTY OF SEDGWICK  
Clarence Michael of Sage Drilling Co. (employee, owner) or (owner or operator) of the above described

being first duly sworn on oath, says: That I have knowledge of the facts, statements, and matters herein contained and the log of the above described well as filed and that the same are true and correct. So help me God.

(Signature) Clarence Michael  
500 Bitting Building, Wichita, Kansas  
(Address)

Subscribed and Sworn to before me this 11th day of October, 19 73.



Louise K. Whitted  
Notary Public.

My commission expires November 26, 1974.

DRILLERS LOG

WILSON NO. 1

CASING RECORD:	OPERATOR: W. L. Hartman	DESCRIPTION:
8-5/8" @ 448' w/275 sax cement	CONTRACTOR: Sage Drilling Co.	SE NW NW Sec. 4-22S-33W Finney Co., Kansas
TOTAL DEPTH: 4835'	COMMENCED: September 19, 1973	ELEVATION: 2887KB
	COMPLETED: October 6, 1973	

<u>FORMATION</u>	<u>FROM</u>	<u>TO</u>	<u>REMARKS</u>
Surface Soil & Sand	0	450	
Shale & Sand	450	1500	
Shale & Shells	1500	2005	
Anhydrite	2005	2019	
Shale & Lime	2019	2190	
Shale	2190	2435	
Lime & Shale	2435	2636	
Shale	2636	2740	
Lime & Shale	2740	3100	
Shale & Lime	3100	3290	
Lime & Shale	3290	3800	
Lime	3800	4835	D&A

RECEIVED  
STATE CORPORATION COMMISSION  
OCT 12 1973  
CONSERVATION DIVISION  
Wichita, Kansas

I certify that this is a true and correct copy of the above log to the best of my knowledge.

SAGE DRILLING CO., INC.

By Clarence Michael  
Clarence Michael



and sworn to before me this 11th day of October, 1973.

Louise K. Whitted  
Louise K. Whitted - Notary Public

My commission expires:  
November 26, 1974.