


WELL PLUGGING RECORD

Give All Information Completely
Make Required Affidavit
Mail or Deliver Report to:
Conservation Division
State Corporation Commission
211 No. Broadway
Wichita, Kansas

NORTH

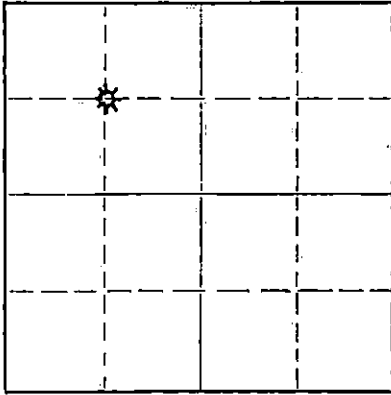

Locate well correctly on above
Section Plat

Finney County, Sec. 4 Twp. 22 Rge. (E) 33 (W)
Location as "NE/CNW/SW" or footage from lines C NW/4
Lease Owner Kansas-Nebraska Natural Gas Company, Inc.
Lease Name Wilson Well No. 1
Office Address P. O. Box 608, Hastings, Nebraska
Character of Well (completed as Oil, Gas or Dry Hole) Gas Well
Date well completed 4/6 19 61
Application for plugging filed 8/28 19 64
Application for plugging approved 8/3 19 64
Plugging commenced 9/30 19 64
Plugging completed 9/30 19 64
Reason for abandonment of well or producing formation No longer capable of commercial production
If a producing well is abandoned, date of last production June 19 63
Was permission obtained from the Conservation Division or its agents before plugging was commenced? Yes

Name of Conservation Agent who supervised plugging of this well Hugh Scott
Producing formation Herrington & Krider Depth to top 2490 Bottom 2556 Total Depth of Well 2580 Feet
Show depth and thickness of all water, oil and gas formations.

OIL, GAS OR WATER RECORDS

CASING RECORD

FORMATION	CONTENT	FROM	TO	SIZE	PUT IN	PULLED OUT
Hollenberg	Gas	2490	2512	8-5/8	291	None
Herrington	Gas	2512	2521	5-1/2	2579	920
Krider	Gas	2521	2556			

Describe in detail the manner in which the well was plugged, indicating where the mud fluid was placed and the method or methods used in introducing it into the hole. If cement or other plugs were used, state the character of same and depth placed, from _____ feet to _____ feet for each plug set.

Mixed 20 sacks cement with pump truck and pumped casing plug to 2420. Shot pipe loose at 1220', pulled 920' 5 1/2" casing. Mixed 35 sacks cement with pump truck and pumped down 5 1/2" casing. Plug 300 feet to 200 feet. Pulled balance of casing. Put 15 sacks plug 45 feet to 0.

10-21-64

RECEIVED
STATE CORPORATION COMMISSION

OCT 21 1964

CONSERVATION DIVISION
Wichita, Kansas

(If additional description is necessary, use BACK of this sheet)

Name of Plugging Contractor Sargent's Casing Pulling Service
Address 121 West 9th Street, Liberal, Kansas

STATE OF NEBRASKA, COUNTY OF ADAMS, ss.
S. D. Ford, Jr. (employee of owner) or (owner or operator) of the above-described well, being first duly sworn on oath, says: That I have knowledge of the facts, statements, and matters herein contained and the log of the above-described well as filed and that the same are true and correct. So help me God.

(Signature) *S. D. Ford, Jr.*
S. D. Ford, Jr.
P. O. Box 608, Hastings, Nebraska
(Address)

SUBSCRIBED AND SWORN TO before me this 20th day of October, 1964

My commission expires January 23, 1970

F. S. WHITE Notary Public.

WILSON #1

15-055-00271-0000

WELL RECORD:

LOCATION:

C NW Section 4-22-33
Finney County, Kansas

Commenced: 3/3/61
Completed: 3/9/61
(Rotary)

CONTRACTOR:

Graham-Michaelis Drilling Co.
Liberal Division
P. O. Box 896
Liberal, Kansas

CASING RECORD:

7 Jts. 8 5/8" 24// Casing
Cemented w/200 sx Pozmix 2% cc

	LOG
Sand, Soil & Clay	0 - 40
Sand & Shale	40 - 295
Shale	295 - 1094
Shale, Sand, Red Bed & Anhy	1094 - 1593
Sand, Shale & Anhy	1593 - 2155
Shale & Lime w/Anhy streaks	2155 - 2322
Lime, Shale & Pyrite	2322 - 2460
Lime & Shale	2460 - 2580

2580' - Total Rotary Depth

The undersigned, Graham-Michaelis Drilling Company, Liberal Division, certifies that the above log is a true and correct copy of the formations encountered in drilling the above mentioned well, as taken from the Daily Drilling Report.

GRAHAM-MICHAELIS DRILLING COMPANY
LIBERAL DIVISION

By H. R. Michaelis
H. R. Michaelis

RECEIVED
STATE CORPORATION COMMISSION

NOV 20 1964

CONSERVATION DIVISION
Wichita, Kansas