

WELL PLUGGING RECORD


Give All Information Completely
Make Required Affidavit
Mail or Deliver Report to:
Conservation Division
State Corporation Commission
800 Bitting Building
Wichita, Kansas

OR 15-009-05568-0000
FORMATION PLUGGING RECORD Strike out upper line when reporting plugging off formations.

Barton County. Sec. 31 Twp. 16S Rge. (E) 11W (W)

Location as "NE $\frac{1}{4}$ NW $\frac{1}{4}$ SW $\frac{1}{4}$ " or footage from lines. NE Corner
Lease Owner. Black Marshall Oil Co.
Lease Name. Valenta Well No. 2
Office Address. Great Bend, Kansas
Character of Well (completed as Oil, Gas or Dry Hole). Dry
Date well completed. December 13, 1944 19
Application for plugging filed. December 20 19 44
Application for plugging approved. January 4 19 45
Plugging commenced. December 21, 1944 19
Plugging completed. December 28, 1944 19
Reason for abandonment of well or producing formation. Dry

NORTH

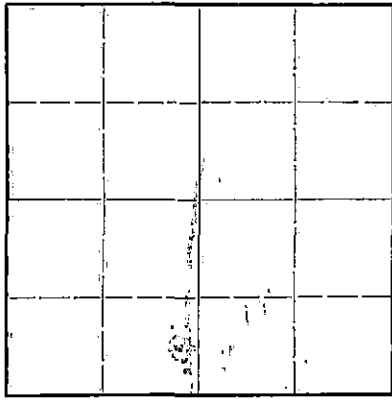

Locate well correctly on above Section Plat

If a producing well is abandoned, date of last production. 19
Was permission obtained from the Conservation Division or its agents before plugging was commenced? Yes
Name of Conservation Agent who supervised plugging of this well. H. W. Kerr
Producing formation. None Depth to top. Bottom. Total Depth of Well 3370' Feet
Show depth and thickness of all water, oil and gas formations.


OIL, GAS OR WATER RECORDS

CASING RECORD

Formation	Content	From	To	Size	Put In	Pulled Out
Sand	Water	135		8 5/8	253'	Cemented
Sand	Water	210				W/80 Sacks
Sand	Water	335	355			
Sand	Water	465	500	5 1/2"	3359'	2515' 9"
						Cemented W/175 Sacks.

Describe in detail the manner in which the well was plugged, indicating where the mud fluid was placed and the method or methods used in introducing it into the hold. If cement or other plugs were used, state the character of same and depth placed, from feet to feet for each plug set.

Run 6-Sacks of Cement in bottom of hole, filled with heavy mud, run 3 Sacks of cement at 2560, filled with heavy mud to 240', Bridge was set and 10- sacks cement run, mudded hole from top of cement to 15' and run 5- sacks of cement to surface.

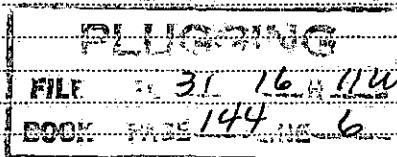

(If additional description is necessary, use BACK of this sheet)

Correspondence regarding this well should be addressed to Black Marshall Oil Company
Address. Great Bend, Kansas

STATE OF Kansas COUNTY OF Barton ss.
Walter C Roberts (employee of owner) or (owner or operator) of the above-described well,
being first duly sworn on oath, says: That I have knowledge of the facts, statements, and matters herein contained and the log of the above-described well as filed and that the same are true and correct. So help me God.

(Signature) Walter C Roberts
Claflin, Kansas (Address)

SUBSCRIBED AND SWORN to before me this 11 day of January 19 45 01-13-45

My commission expires February 5, 1947

Edwin Wojdyak Notary Public.

COMPANY: Black-Marshall Oil Co.
CONTRACTOR: Hannum Drilling Co.

FARM: Valenta #2
LOCATION: NE NE NE 31-16-11W.
Barton County, Kansas.

COMMENCED: November 2, 1944.
COMPLETED: November 22, 1944.

CASING RECORD: 8 5/8" used cag.
cemented at 249' with 80 sax.
(rotary measure)
5 1/2" casing cemented 7' off bottom
with 175 sax cement. (

ELEVATION: 1911
PRODUCTION:

FORMATION	DEPTH	FORMATION	DEPTH
Shale	80	Lime & shale	2635
Sand & shale	135	Shale & shells	2715
Shale	190	Lime & shale	2763
Sand	210	Shale	2770
Broken Lime	249	Lime & shale	2845
Shale & shells	335	Lime	2980
Sand	355	Shale & shells	3044
Shale & shells	800	Shale	3055
Anhydrite	830	Lime	3138
Shale & shell	###1200	Shale	3142
Salt & shale	1300	Lime	3329
Shale & shells	1435	Cherty Cong.	3349
Broken Lime & shale	1555	Lime	3354
Lime	1655	Cherty Conglomerate	3370
Lime & shale	1750		
Broken Lime	1815	TOTAL DEPTH ROTARY MEASURE	###
Broken Lime & chert	1940		3370'
Broken Lime	1995		
Shale & shell	2490		

I hereby certify this to be a correct and accurate log of the above described well as shown by the drilling reports.

HANNUM DRILLING COMPANY

BY: *W. J. Wright*

Subscribed and sworn to before me this 27th day of November, 1944.

Maxine Fisher
Notary Public

My commission expires *August 31, 1946*

FIL: 31 16 11W
BOOK: 144 - 6 -

