


Give All Information Completely
Make Required Affidavit
Mail or Deliver Report to:
Conservation Division
State Corporation Commission
212 North Market, Insurance Bldg.
Wichita, Kansas

WELL PLUGGING RECORD

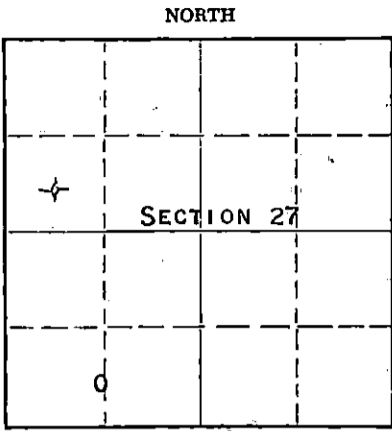

Locate well correctly on above Section Plat

KINGMAN County, Sec. 27 Twp. 30S Rge. 9W (W)
Location as "NE/CNW/SW" or footage from lines C S/2 SW NW
Lease Owner PETROLEUM, INC.
Lease Name SWINGLE "D" Well No. 1
Office Address ROUTE 2, GREAT BEND, KANSAS
Character of Well (completed as Oil, Gas or Dry Hole) DRY HOLE
Date well completed AUGUST 7 19 59
Application for plugging filed AUGUST 7 19 59
Application for plugging approved AUGUST 7 19 59
Plugging commenced AUGUST 7 19 59
Plugging completed AUGUST 7 19 59
Reason for abandonment of well or producing formation NO PRODUCIBLE ZONES

If a producing well is abandoned, date of last production NONE 19
Was permission obtained from the Conservation Division or its agents before plugging was commenced? YES

Name of Conservation Agent who supervised plugging of this well FRED W. HAMPEL, PRETTY PRAIRIE, KANSAS
Producing formation ----- Depth to top ----- Bottom ----- Total Depth of Well 4350 Feet
Show depth and thickness of all water, oil and gas formations.

OIL, GAS OR WATER RECORDS

CASING RECORD

| FORMATION | CONTENT | FROM | TO | SIZE | PUT IN | PULLED OUT |
|-----------|---------|------|----|--------|----------|------------|
| | | | | 8-5/8" | 258 1/2' | NONE |
| | | | | | | |
| | | | | | | |
| | | | | | | |
| | | | | | | |
| | | | | | | |

Describe in detail the manner in which the well was plugged, indicating where the mud fluid was placed and the method or methods used in introducing it into the hole. If cement or other plugs were used, state the character of same and depth placed, from _____ feet to _____ feet for each plug set.

MUD UP WITH HEAVY MUD TO 240' FOLLOWED BY A WOODEN PLUG AND 1/4 SACK HULLS.
PLACED 18 SACKS OF CEMENT THROUGH DRILL PIPE ON TOP OF PLUG. MUD UP TO 40'
FOLLOWED BY A WOODEN PLUG AND 1/4 SACK OF HULLS. FILLED HOLE TO BASE OF WELL
CELLAR WITH 12 SACKS OF CEMENT.

RECEIVED
STATE CORPORATION COMMISSION

AUG 20 1959

CONSERVATION DIVISION
Wichita, Kansas

8-20-59

(If additional description is necessary, use BACK of this sheet)

Name of Plugging Contractor GARVEY DRILLING COMPANY
Address ROUTE 2, GREAT BEND, KANSAS

STATE OF KANSAS, COUNTY OF BARTON, ss.
DON SEARLE (employee of owner) or (owner) of the above-described well, being first duly sworn on oath, says: That I have knowledge of the facts, statements, and matters herein contained and the log of the above-described well as filed and that the same are true and correct. So help me God.

(Signature) Don Searle

ROUTE 2, GREAT BEND, KANSAS
(Address)

SUBSCRIBED AND SWORN TO before me this 19TH day of AUGUST, 19 59

My commission expires APRIL 14, 1963

Arthur J. Wells
Notary Public.

PLUGGING
FILE SEC. 27, 30 R. 9W
BOOK PAGE 50 LINE 23

WELL LOG

15-095-00341-0000

COMPANY PETROLEUM, INCORPORATED

SEC. 27 T. 30S R. 9W

FARM SWINGLE "D" NO. 1

LOC. C-S/2, SW, NW


TOTAL DEPTH 4350'

COUNTY KINGMAN CO., KANSAS

COMM. July 28, 1959

COMP. August 7, 1959

CONTRACTOR GARVEY DRILLING COMPANY

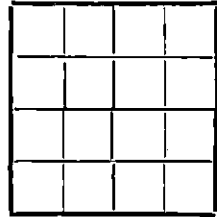

CASING 8 5/8" @ 258 1/2 W/225 sax.

ELEVATION 1597' DF

PRODUCTION D & A

FIGURES INDICATE BOTTOM OF FORMATIONS

| | |
|------|----------------------|
| 10 | Surface clay |
| 25 | Sand |
| 258 | Red bed & rock |
| 710 | Red bed |
| 750 | Shale |
| 765 | Anhydrite |
| 1315 | Shale & shells |
| 1340 | Anhydrite |
| 1560 | Shale & lime |
| 1950 | Lime |
| 2050 | Lime & shale |
| 2390 | Shale & lime |
| 2525 | Shale & shells |
| 3055 | Shale w/lime streaks |
| 3265 | Sandy lime & shale |
| 3415 | Lime & shale |
| 3522 | Shale & sand |
| 3634 | Shale, sand & lime |
| 4075 | Lime |
| 4264 | Shale & lime |
| 4288 | Chert & lime |
| 4350 | Lime |
| 4350 | T. D. |

RECEIVED
STATE CORPORATION COMMISSION

AUG 20 1959

CONSERVATION DIVISION
Wichita, Kansas

State of KANSAS }
County of BARTON } SS:

I, VERNE A. MORRIS of GARVEY DRILLING COMPANY

upon oath state that the above and foregoing is a true and correct copy of the log of the #1 SWINGLE "D" well

Verne A. Morris

Subscribed and sworn to before me this 18th day of August 1959

My Commission Expires: April 14, 1963

PLUGGING
FILE SEC. 27 T. 30 R. 9W
BOOK PAGE 52 LINE 23

Robert J. Giles
NOTARY PUBLIC