


WELL PLUGGING RECORD

Give All Information Completely
Make Required Affidavit
Mail or Deliver Report to:
Conservation Division
State Corporation Commission
211 No. Broadway
Wichita, Kansas

KINGMAN County. Sec. 27 Twp. 30S Rge. (E) 9 (W)

Location as "NE/CNW/SW" or footage from lines G NW SW SE
Lease Owner PICKRELL DRILLING COMPANY
Lease Name GOENNER Well No. 1
Office Address 705 4TH NATL. BANK BLDG, WICHITA, KANSAS
Character of Well (completed as Oil, Gas or Dry Hole) DRY HOLE
Date well completed March 8 1963
Application for plugging filed March 9 1963
Application for plugging approved March 9 1963
Plugging commenced March 9 1963
Plugging completed March 9 1963
Reason for abandonment of well or producing formation Dry Hole

NORTH

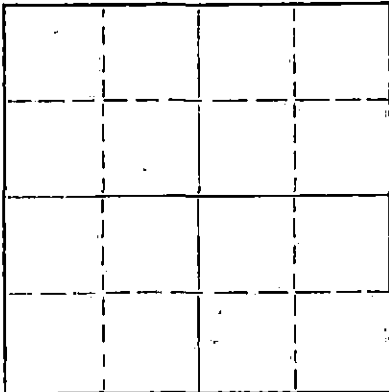

Locate well correctly on above
Section Plot

If a producing well is abandoned, date of last production 19
Was permission obtained from the Conservation Division or its agents before plugging was commenced? Yes

Name of Conservation Agent who supervised plugging of this well Fred Hampel
Producing formation _____ Depth to top _____ Bottom _____ Total Depth of Well 4457 Feet
Show depth and thickness of all water, oil and gas formations.

OIL, GAS OR WATER RECORDS

CASING RECORD

FORMATION	CONTENT	FROM	TO	SIZE	PUT IN	PULLED OUT
				8 5/8	252	None

Describe in detail the manner in which the well was plugged, indicating where the mud fluid was placed and the method or methods used in introducing it into the hole. If cement or other plugs were used, state the character of same and depth placed, from _____ feet to _____ feet for each plug set.

Heavy mud to 180'. Set plug. Cemented with
20 sacks cement. Heavy mud to 40'. Set plug.
Cemented with 10 sacks cement to bottom of
cellar. Plugged rat hole with 2 sacks cement.

RECEIVED
STATE CORPORATION COMMISSION

MAR 14 1963
3-14-63

CONSERVATION DIVISION
Wichita, Kansas

(If additional description is necessary, use BACK of this sheet)

Name of Plugging Contractor PICKRELL DRILLING COMPANY
Address 705 4TH NATIONAL BANK BUILDING, WICHITA, KANSAS

STATE OF KANSAS COUNTY OF SEDGWICK, ss.
C. W. SEBTS

~~You do not have to sign~~ (owner or operator) of the above-described well, being first duly sworn on oath, says: That I have knowledge of the facts, statements, and matters herein contained and the log of the above-described well as filed and that the same are true and correct. So help me God.

(Signature) C. W. SEBTS
705 4th NATL BANK BLDG, WICHITA, KANSAS
(Address)

SUBSCRIBED AND SWORN TO before me this 11th day of March, 1963

My commission expires June 21, 1966

Maxine Blackman
Maxine Blackman
Notary Public.



ROTARY DRILLING LOG

COMPANY: PICKRELL DRILLING COMPANY
705 4TH NATL BANK BLDG
WICHITA, KANSAS
LOCATION: GOENNER NO. 1, NW SW SE-27-30S-9W
KINGMAN COUNTY, KANSAS

Rotary Drilling Commenced 2-27-63
Rotary Drilling Completed 3--8-63

CONTRACTOR: PICKRELL DRILLING COMPANY -
Wichita, Kansas

CASING RECORD: (7 jts) 8 5/8" Surface Casing set at 252', cemented with
190 sacks cement. Circulated. Completed 6:15 P.M. 2-27-63.
No oil string run. D & A.

LOG

(Figures indicate bottom of formation — measurements from top of rotary bushing.)

90 Sand
253 Red Rock
840 Red Rock & Shale
1525 Shale & Shells
1715 Shale and Lime
1930 Lime
3700 Lime and Shale
4190 Lime
4355 Lime and Shale
4457 Mississippian - RTD

C. F. S.
4369
4380
4405
4418
4457

Slope Tests
2500
3000
3500
4000

S. L. M.
3601
3930
4326

RECEIVED
STATE CORPORATION COMMISSION

MAR 14 1963

CONSERVATION DIVISION
Wichita, Kansas

The undersigned, C. W. SEBITS, Attorney-in-Fact for PICKRELL DRILLING COMPANY, hereby certifies in behalf of said Company, that the above is a true and correct log of the formation encountered in drilling the above well as reflected by the Daily Drilling Reports.

PICKRELL DRILLING COMPANY
By [Signature]
C. W. SEBITS Attorney-in-Fact

STATE OF KANSAS }
COUNTY OF SEDGWICK } ss.:

On this 11th day of March, 19 63, before me the undersigned, a Notary Public, in and for the County and State aforesaid, personally appeared C. W. SEBITS, to me known to be the identical person who subscribed the name of PICKRELL DRILLING COMPANY to the foregoing instrument as its Attorney-in-Fact and acknowledged to me that he executed the same as his free and voluntary act and deed, and as the free and voluntary act and deed of such company, for the uses and purposes therein set forth.

Given under my hand and seal of office the day and year last above written.

My commission expires: June 21, 1966

[Signature]
Maxine Blackman Notary Public