


STATE OF KANSAS  
STATE CORPORATION COMMISSION

WELL PLUGGING RECORD

Give All Information Completely.  
Make Required Affidavit  
Mail or Deliver Report to  
Conservation Division  
State Corporation Comm.  
245 North Water  
Wichita, KS 67202

Kingman County, Sec. 27 Twp. 30S Rge. 9W E/W  
Location as "NE/CNW $\frac{1}{4}$ SW $\frac{1}{4}$ " or footage from lines

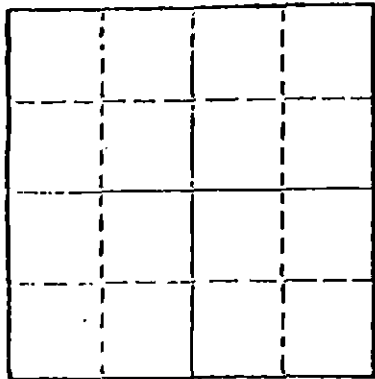

Locate well correctly on above  
Section Plat

N/2 SE SE  
Lease Owner The Maurice L. Brown Company  
Lease Name Keimig Well No. 1  
Office Address 200 Sutton Place, Wichita, KS 67202  
Character of Well (Completed as Oil, Gas or Dry Hole)  
Dry Hole  
Date Well completed 12/10/77 19  
Application for plugging filed 12/10/77 19  
Application for plugging approved 12/10/77 19  
Plugging commenced 12/10/77 19  
Plugging completed 12/10/77 19  
Reason for abandonment of well or producing formation

If a producing well is abandoned, date of last production 19

Was permission obtained from the Conservation Division or its agents before plugging was commenced? Yes

Name of Conservation Agent who supervised plugging of this well Bill Owens  
Producing formation Depth to top Bottom Total Depth of Well  
Show depth and thickness of all water, oil and gas formations.

OIL, GAS OR WATER RECORDS

CASING RECORD

FORMATION	CONTENT	FROM	TO	SIZE	PUT IN	PULLED OUT
	Surface	0	263	8 5/8	Yes	No

Describe in detail the manner in which the well was plugged, indicating where the mud fluid was placed and the method or methods used in introducing it into the hold. If cement or other plugs were used, state the character of same and depth placed, from feet to feet for each plug set.

Run plugging stands in hole  
Bottom plug @ 210' with 35 sxs  
Top plug @ 40' to surface with 125 sxs

RECEIVED  
STATE CORPORATION COMMISSION

JAN 27 1978 1-27-78

(If additional description is necessary, use BACK of this sheet)

Name of Plugging Contractor Gabbert-Jones, Inc.


STATE OF KANSAS COUNTY OF SEDGWICK, ss.  
Vern Haselhorst (employee of owner) or (owner or operator)  
of the above-described well, being first duly sworn on oath, says: That I have knowledge of the facts, statements, and matters herein contained and the log of the above-described well as filed and that the same are true and correct. So help me God.

(Signature) Vern Haselhorst  
200 Sutton Place, Wichita, KS 67202  
(Address)

SUBSCRIBED AND SWORN TO before me this 26th day of January, 19

Kathleen L. Leake Notary Public.

My commission expires 10/1/78

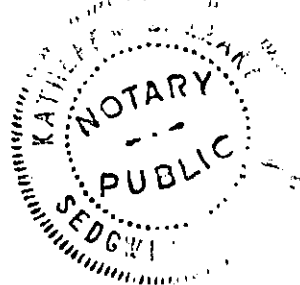

GABBERT-JONES, INC.  
WICHITA, KANSAS  
DRILLERS' WELL LOG

Kemig #1  
N/2 SE SE Sec 27-30S-9W  
Kingman County Kansas

Commenced: 11-29-77

Completed: 12-10-77

OPERATOR: MAURICE L. BROWN

From	Depth to	Formation	Remarks
0	280	Redbed	Ran 8 jts of 28# 8 5/8" csg. set @ 263' Cemented w/ 225 sks Class A 3% CC PD @ 5:30 p.m. 11-29-77
280	1225	Redbed-Shale	
1225	1595	Shale	
1595	2130	Shale-Lime	
2130	2340	Lime-Shale	
2340	2765	Lime	
2765	2940	Lime-Shale	
2940	3165	Shale-Lime	
3165	3530	Lime	
3530	3600	Sand	
3600	4295	Lime	
4295	4343	Shale	
4343	4420	Lime	
	4420 - TD		

RECEIVED  
STATE CORPORATION COMMISSION  
JAN 27 1978  
CONSERVATION DIVISION  
Wichita, Kansas

STATE OF KANSAS )  
                          ) SS  
COUNTY OF SEDGWICK)

I, the undersigned, being duly sworn on oath, state that the above Drillers' Well Log is true and correct to the best of my knowledge and belief and according to the records of this office.

GABBERT-JONES, INC.

*James S. Sutton II*  
JAMES S. SUTTON II

Subscribed and sworn to before me this 13th day of December, 1977.

*Elizabeth J. Edwards*  
ELIZABETH J. EDWARDS-NOTARY PUBLIC

My Commission expires February 6, 1979.

