


Give All Information Completely  
Make Required Affidavit  
Mail or Deliver Report to:  
Conservation Division  
State Corporation Commission  
800 Bittling Building  
Wichita, Kansas

15-095-00077-0000

WELL PLUGGING RECORD

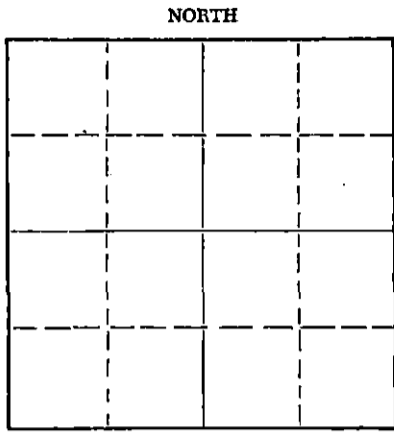

Locate well correctly on above  
Section Plat

Kingman County, Sec. 28 Twp. 30S Rge. 9 (E) (W)  
Location as "NE/CNW/SW" or footage from lines NW NW SW  
Lease Owner Welch & Olsson Drilling Co. Inc.  
Lease Name Graham Well No. 1  
Office Address 203 Rule Bldg. Wichita, Kansas  
Character of Well (completed as Oil, Gas or Dry Hole) D & A  
Date well completed 6-11 19 55  
Application for plugging filed 6-11 19 55  
Application for plugging approved 6-11 19 55  
Plugging commenced 6-11 19 55  
Plugging completed 6-11 19 55  
Reason for abandonment of well or producing formation D & A

If a producing well is abandoned, date of last production 19  
Was permission obtained from the Conservation Division or its agents before plugging was commenced? Yes

Name of Conservation Agent who supervised plugging of this well M. A. Rives, Box 8, Pratt, Kansas  
Producing formation Depth to top Bottom Total Depth of Well 4550' Feet  
Show depth and thickness of all water, oil and gas formations.

OIL, GAS OR WATER RECORDS

CASING RECORD

FORMATION	CONTENT	FROM	TO	SIZE	PUT IN	PULLED OUT
				8 5/8"	210'	None

Describe in detail the manner in which the well was plugged, indicating where the mud fluid was placed and the method or methods used in introducing it into the hole. If cement or other plugs were used, state the character of same and depth placed, from feet to feet for each plug set.

Mudded to 206' ; put in 1/3rd sacks of hulls. Set plug.

Cemented with 20 sacks of cement thru drill pipe. Filled

hole with mud to 35'; added 1/3rd sacks of hulls and plug

and cemented with 10 sacks of cement. Cemented to bottom

of cellar.

8-19-55  
RECEIVED  
STATE CORPORATION COMMISSION

AUG 19 1955

CONSERVATION DIVISION  
Wichita, Kansas

(If additional description is necessary, use BACK of this sheet)  
Name of Plugging Contractor Welch & Olsson Drilling Company, Inc.  
Address 203 Rule Bldg. Wichita, Ks.

STATE OF Kansas COUNTY OF Sedgwick ss.  
R. E. Welch (employee of owner) or (owner or operator) of the above-described

well, being first duly sworn on oath, says: That I have knowledge of the facts, statements, and matters herein contained and the log of the above-described well as filed and that the same are true and correct. So help me God.

(Signature) *R. E. Welch*  
203 Rule Bldg. Wichita, Kansas.

SUBSCRIBED AND SWORN TO before me this 16th day of June, 19 55

My commission expires June 12, 1959 Notary Public.

PLUGGING  
FILE SEC. 28 T. 30 S. R. 9 W  
BOOK PAGE 126 LINE 15

WELL LOG.

WELCH & OLSSON DRILLING COMPANY, INC.  
 CONTRACTOR: Welch & Olsson Drlg. Co. Inc.  
 GRAHAM #1  
 NW NW SW 28-30S-9W  
 Kingman County, Kansas:

Elevation: 1658 R.B.  
 Comm. Drlg: 5-27-55  
 Compl. Drlg: 6-11-55  
 Production: D & A

Casing Record.

Set 210' of 8 5/8" with 175 sacks of cement.

(Figures indicated bottom of formations.)

<u>FORMATIONS:</u>	<u>DEPTHS:</u>	<u>FORMATION TOPS:</u>
Sand:	75	Heebner Shale: 3430 (-1996)
Red Bed:	255	Toronto ls. 3462 (-1804)
Red Bed & Shale:	600	Douglas Sst. 3561 (-1903)
Shale & Shells:	1450	Lansing-Ks. City: 3654 (-1996)
Shale & Lime:	1490	Base Kansas City: 4144 (-2386)
Lime & Shale:	1660	Conglomerate: 4315 (-2657)
Lime:	1875	Mississippi Chat: 4343 (-2685)
Shale W/Lime Strs:	2000	Mississippi Lime: 4354 (-2696)
Lime:	2155	Kinderhook: 4434 (-2793)
Lime W/shale Brks:	2300	
Shale & Shells:	2450	
Shale & Lime:	2925	
Lime:	3185	
Lime & Shale:	3385	
Shale & Sand:	3490	
Lime & Shale:	3590	
Sand:	3657	
Lime:	4210	
<del>Kingston</del> Lime & Shale:	4298	
Lime:	4345	
Miss. Chat:	4355	
Lime:	4375	
Lime & Chert:	4405	
Lime W/Tr. Chert:	4472	
Shale & Lime:	4498	
Chert:	4550 T.D.	

STATE OF KANSAS, )  
 ) SS:  
 SEDGWICK COUNTY, )

**RECEIVED**  
 STATE CORPORATION COMMISSION  
 AUG 19 1955  
 CONSERVATION DIVISION  
 Wichita, Kansas

I hereby certify that the above is a true and correct copy of Drillers Log of well drilled in the center of NW NW SW of Section 28, Township 30 South, Range 9 West, Kingman County, Kansas.

WELCH & OLSSON DRILLING COMPANY, INC.

BY [Signature]  
 R. E. WELCH

Subscribed and sworn to before me this 16th day of June, 1955.

[Signature]  
 Notary Public.

My commission expires:  
 June 12, 1959

**PLUGGING**  
 SEC 28 T 30 R 9W  
 BOOK PAGE 126 LINE 15