


WELL PLUGGING RECORD

Give All Information Completely  
Make Required Affidavit  
Mail or Deliver Report to:  
Conservation Division  
State Corporation Commission  
212 North Market, Insurance Bldg.  
Wichita, Kansas

HODGEMAN County, Sec. 23 Twp. 22s Rge. 24w (#) (W)  
Location as "NE/CNW/SW" or footage from lines APPROX. C NW SW  
Lease Owner PETROLEUM, INC.  
Lease Name SPRINGER Well No. 2  
Office Address ROUTE 2, GREAT BEND, KANSAS  
Character of Well (completed as Oil, Gas or Dry Hole) DRY HOLE  
Date well completed JANUARY 9 19 61  
Application for plugging filed JANUARY 9 19 61  
Application for plugging approved JANUARY 9 19 61  
Plugging commenced JANUARY 9 19 61  
Plugging completed JANUARY 9 19 61  
Reason for abandonment of well or producing formation NO PRODUCIBLE FORMATIONS  
If a producing well is abandoned, date of last production ----- 19 ---  
Was permission obtained from the Conservation Division or its agents before plugging was commenced? YES

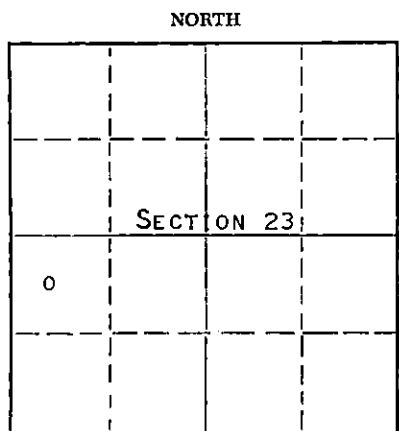

Locate well correctly on above Section Plat

Name of Conservation Agent who supervised plugging of this well MR. W. L. LACKAMP, JR.  
Producing formation ----- Depth to top --- Bottom --- Total Depth of Well 4674 Feet  
Show depth and thickness of all water, oil and gas formations.

OIL, GAS OR WATER RECORDS

CASING RECORD

FORMATION	CONTENT	FROM	TO	SIZE	PUT IN	PULLED OUT
				8-5/8"	431'	NONE

Describe in detail the manner in which the well was plugged, indicating where the mud fluid was placed and the method or methods used in introducing it into the hole. If cement or other plugs were used, state the character of same and depth placed, from --- feet to ----- feet for each plug set.

MUDDED UP WITH HEAVY MUD FROM T.D. 4674' TO 420' FOLLOWED BY A WOODEN PLUG AND 1/4 SACK OF HULLS. PLACED 20 SACKS OF CEMENT THROUGH DRILL PIPE ON TOP OF HULLS. MUDDED UP WITH HEAVY MUD TO 35' FOLLOWED BY A WOODEN PLUG AND 1/4 SACK OF HULLS. PLACED 10 SACKS OF CEMENT ON TOP OF HULLS TO BASE OF WELL CELLAR.

2-3-61

RECEIVED  
STATE CORPORATION COMMISSION  
FEB 7  
CONSERVATION DIVISION  
WICHITA

(If additional description is necessary, use BACK of this sheet)  
Name of Plugging Contractor GARVEY DRILLING COMPANY  
Address ROUTE 2, GREAT BEND, KANSAS

STATE OF KANSAS, COUNTY OF BARTON, ss.  
DON SEARLE (employee of owner) or (~~owner~~) of the above-described well, being first duly sworn on oath, says: That I have knowledge of the facts, statements, and matters herein contained and the log of the above-described well as filed and that the same are true and correct. So help me God.

(Signature) Don Searle  
ROUTE 2, GREAT BEND, KANSAS  
(Address)

SUBSCRIBED AND SWORN TO before me this 2ND day of FEBRUARY, 19 61

Arthur J. Miles Notary Public.  
My commission expires APRIL 14, 1963



# WELL LOG

15-083-10171-6000

COMPANY PETROLEUM, INCORPORATED

SEC. 23 T. 22S R. 24W

FARM SPRINGER NO. 2


LOC. C-NW, SW

TOTAL DEPTH x 4674'

COUNTY HODGEMAN CO., KANSAS

COMM. December 26, 1960 COMP. January 9, 1961

CONTRACTOR GARVEY DRILLING COMPANY

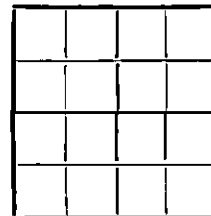

CASING 8 5/8" @ 431' w/250 sax.

ELEVATION 2406' DF

PRODUCTION D & A

FIGURES INDICATE BOTTOM OF FORMATIONS

30	Surface clay
420	Shale & sand
431	Clay
720	Shale
1095	Red bed
1310	Sand
2000	Shale
2355	Shale & lime
2505	Lime & shale
2750	Lime
2845	Lime & shale
2920	Lime
3915	Lime & shale
4034	Shale & lime
4363	Lime
4415	Lime & shale
4501	Lime
4546	Shale & lime
4575	Lime & shale
4674	Mississippi lime
4674	T. D.

**RECEIVED**  
STATE CORPORATION COMMISSION  
FEB 3 1961  
CONSERVATION DIVISION  
Wichita, Kansas

State of KANSAS }  
County of BARTON } ss.

I, VERNE A. MORRIS of GARVEY DRILLING COMPANY

upon oath state that the above and foregoing is a true and correct copy of the log of the #2 SPRINGER well

Subscribed and sworn to before me this 31st day of January 1961

My Commission Expires: April 14, 1963

*Verne A. Morris*  
*Arthur J. Smith*  
NOTARY PUBLIC