


STATE OF KANSAS
STATE CORPORATION COMMISSION

Give All Information Completely
Make Required Affidavit
Mail or Deliver Report to:
Conservation Division
State Corporation Commission
809 Bittling Building
Wichita, Kansas

WELL PLUGGING RECORD

NORTH

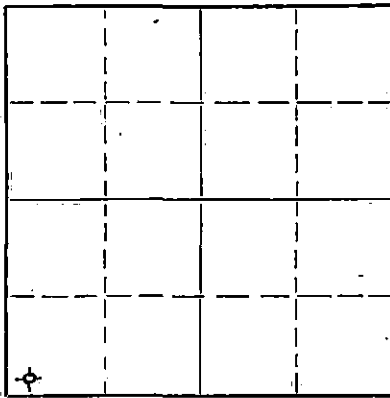

Locate well correctly on above
Section Plat

Hodgeman County, Sec. 23 Twp. 22S Rge. 24W (#) (W)
Location as "NE/CNWxSWx" or footage from lines SW SW SW
Lease Owner Imperial Drilling Company, Inc.
Lease Name Springer Well No. 1
Office Address 903 Union National Bank Building, Wichita, Kansas
Character of Well (completed as Oil, Gas or Dry Hole) Dry Hole
Date well completed January 9 1953
Application for plugging filed January 9 1953
Application for plugging approved January 9 1953
Plugging commenced 4:00 p.m., January 9 1953
Plugging completed 11:30 p.m., January 9 1953
Reason for abandonment of well or producing formation
Commercial quantity of oil not found
If a producing well is abandoned, date of last production _____ 19____
Was permission obtained from the Conservation Division or its agents before plugging was commenced? Yes

Name of Conservation Agent who supervised plugging of this well C. D. Stough
Producing formation _____ Depth to top _____ Bottom _____ Total Depth of Well 4675 Feet
Show depth and thickness of all water, oil and gas formations.

OIL, GAS OR WATER RECORDS

CASING RECORD

FORMATION	CONTENT	FROM	TO	SIZE	PUT IN	PULLED OUT
				8 5/8"	432'	

Describe in detail the manner in which the well was plugged, indicating where the mud fluid was placed and the method or methods used in introducing it into the hole. If cement or other plugs were used, state the character of same and depth placed, from _____ feet to _____ feet for each plug set.

Plug and bulls at 300' with 20 sacks cement through drill pipe.
Plug and bulls at 40' with 10 sacks cement.

1-17-53

RECEIVED
STATE CORPORATION COMMISSION
JAN 17 1953
COMMUNICATIONS SECTION

(If additional description is necessary, use BACK of this sheet)

Name of Plugging Contractor Deek Drilling, Inc.
Address 1006 Central Building, Wichita, Kansas

STATE OF Kansas, COUNTY OF Sedgwick, ss.
Clinton Engstrand, agent for (owner of well) (owner of surface) of the above-described well, being first duly sworn on oath, says: That I have knowledge of the facts, statements, and matters herein contained and the log of the above-described well as filed and that the same are true and correct. So help me God.

(Signature) Clinton Engstrand
1006 Central Building, Wichita, Kansas
(Address)

SUBSCRIBED AND SWORN TO before me this 15 day of January, 19 53

Wilda Rogers
Notary Public.

My commission expires October 29, 1955

PLUGGING
FILE SEC 23 T 22 S 24 W
BOOK PAGE 72 LINE 41

IMPERIAL DRILLING COMPANY, INC.
NO. 1 SPRINGER

SW SW SW of Sec. 23-22S-24W
Hodgeman County, Kansas

Casing
8 5/8" Set @ 432'
Comm: 12-2-52
Comp: 1-9-53
Total Depth: 4675'

Cement
235 Sacks

<u>FORMATION</u>	<u>DEPTH</u>
Shale - limestone	0 - 215
Shale and Sand	215 - 410
Shale, sand, shells	410 - 432
Shale and Sand	432 - 580
Blue Shale and Sand	580 - 760
Red Bed	760 - 994
Anhydrite	994 - 1000
Sand and Red Bed	1000 - 1425
Red Bed, Shale, shells	1425 - 1605
Shale and Shells	1605 - 2200
Shale and Lime	2200 - 2330
Shale	2330 - 2356
Angydrate	2356 - 2389
Shale and Shells	2389 - 2430
Shale, lime	2430 - 2510
Shale and Lime	2510 - 2602

STUCK @ 2602' PLUGBACK - WHIPSTOCK

Shale and Lime Shells	2460 - 2510
Shale, Lime and Shells	2510 - 2543
Lime and Shale	2543 - 3395
Lime	3395 - 3965
Lime and Shale	3965 - 4002
Lime	4002 - 4313
Lime and Shale	4313 - 4341
Lime	4341 - 4497
Lime and Shale	4497 - 4521
Lime	4521 - 4543
Lime and Chert	4543 - 4545
Lime and Shale	4545 - 4555
Lime	4555 - 4675

STATE OF KANSAS }
SEDGWICK COUNTY } SS

I hereby certify that the above information is true and correct to the best of my knowledge.

[Handwritten Signature]

Subscribed and sworn to before me this 15 day of January, 1953.

[Handwritten Signature]
Notary Public

My Commission Expires: October 29, 1955

PLUGGING
FILE SEC 23-22-24W
BOOK PAGE 72 LINE 41