


STATE OF KANSAS  
STATE CORPORATION COMMISSION

Form CP-4

WELL PLUGGING RECORD

Give All Information Completely  
Make Required Affidavit  
Mail or Deliver Report to:  
Conservation Division  
State Corporation Commission  
P. O. Box 17027  
Wichita, Kansas 67217  
NORTH

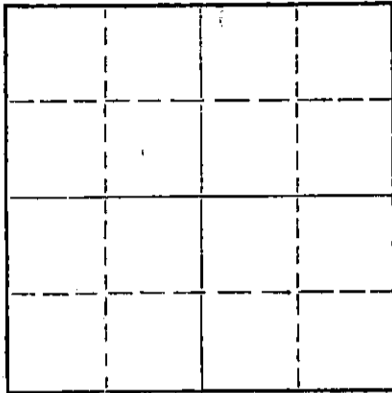

Locate well correctly on above  
Section Plat

Hodgeman County. Sec. 17 Twp. 22S Rge. 24W (E) (W)  
Location as "NE/CNW/SW" or footage from lines C SW/4  
Lease Owner Chief Drilling Co., Inc.  
Lease Name Schauvliege Well No. 1-A  
Office Address 905 Century Plaza, Wichita, Kansas 67202  
Character of Well (completed as Oil, Gas or Dry Hole) Dry Hole  
Date well completed June 10, 1975 19  
Application for plugging filed June 10, 1975 19  
Application for plugging approved June 10, 1975 19  
Plugging commenced June 10, 1975 19  
Plugging completed June 10, 1975 19  
Reason for abandonment of well or producing formation Dry Hole

If a producing well is abandoned, date of last production \_\_\_\_\_ 19\_\_\_\_  
Was permission obtained from the Conservation Division or its agents before plugging was commenced? Yes

Name of Conservation Agent who supervised plugging of this well Clarence F. Thomas  
Producing formation \_\_\_\_\_ Depth to top \_\_\_\_\_ Bottom \_\_\_\_\_ Total Depth of Well 4690 Feet  
Show depth and thickness of all water, oil and gas formations.

OIL, GAS OR WATER RECORDS

CASING RECORD

FORMATION	CONTENT	FROM	TO	SIZE	PUT IN	PULLED OUT
		0	296'	8 5/8"		

Describe in detail the manner in which the well was plugged, indicating where the mud fluid was placed and the method or methods used in introducing it into the hole. If cement or other plugs were used, state the character of same and depth placed, from \_\_\_\_\_ feet to \_\_\_\_\_ feet for each plug set.

Plugged through drill pipe @ 900' w/50 sacks cement  
Plugged through drill pipe @ 325' w/35 sacks cement  
Plugged through drill pipe @ 40' w/10 sacks cement  
Plugged through drill pipe in rat hole w/2 sacks cement

6-17-75

(If additional description is necessary, use BACK of this sheet)

Name of Plugging Contractor Chief Drilling Co., Inc.  
Address 905 Century Plaza, Wichita, Kansas 67202

STATE OF Kansas, COUNTY OF Sedgwick, ss.  
Jim Robinson (employee of owner) or (owner or operator) of the above-described well, being first duly sworn on oath, says: That I have knowledge of the facts, statements, and matters herein contained and the log of the above-described well as filed and that the same are true and correct. So help me God.

(Signature) Jim Robinson  
905 Century Plaza, Wichita, Ka. 67202  
(Address)

SUBSCRIBED AND SWORN TO before me this 16th day of June, 19 75

My commission expires \_\_\_\_\_

MARILYN SINARD  
STATE NOTARY PUBLIC  
SEDGWICK COUNTY, KANSAS  
MY COMM. EXP. APR. 30, 1979

Marilyn Sinard  
Marilyn Sinard  
Notary Public.

WELL LOG

15-083-20424-0000

CHIEF DRILLING CO., INC.  
905 Century Plaza  
Wichita, Kansas 67202

#1-A SCHAUVLIEGE  
C SW/4 Sec. 17-22S-24W  
Hodgeman County, Kansas

CONTRACTOR: Chief Drilling Co., Inc.  
CASING RECORD: Ran (7 Jts.) 8 5/8" used 28#,  
290'; set @ 296', cemented w/200  
sacks common quick set 2% gel.

COMMENCED: 6/2/75  
COMPLETED: 6/10/75

FORMATION	FROM	TO	ELEVATIONS
Shale	0	1094	2486 Gr.
Shale & Sand	1094	1816	2489 D.F.
Shale	1816	1980	2491 K.B.
Shale & Lime	1980	2568	
Lime	2568	2795	
Lime & Shale	2795	2978	
Lime	2978	3667	
Shale & Lime	3667	3913	
Lime & Shale	3913	4034	
Lime	4034	4690	
Total Depth	4690		

FORMATION TOPS		
Anhy.	1680 +	811
Base Anhy.	1714 +	777
Heebner	3944 -	1453
Lansing	3995 -	1504
Base KC	4402 -	1911
Ft. Scott	4544 -	2053
Congl.	4627 -	2136
Rework Miss.	4638 -	2147
Miss. Dolo.	4678 -	2187
Total Depth	4690 -	2199

RECEIVED  
STATE CORPORATION COMMISSION

JUN 17 1975

CONSERVATION DIVISION  
Wichita, Kansas

STATE OF KANSAS, COUNTY OF SEDGWICK) ss:

I hereby certify that the above is a true and correct copy of the  
Driller's Log of the well drilled in the C SW/4 Sec. 17-22S-24W  
Hodgeman County, Kansas, to the best  
of my knowledge and belief.

CHIEF DRILLING CO., INC.

Jim Robinson  
Jim Robinson, Vice-President

Subscribed and sworn to before me this 16th day of June, 1975.

MARILYN SINARD  
STATE NOTARY PUBLIC  
SEDGWICK COUNTY, KANSAS  
MY COMM. EXP. APR. 30, 1979

Marilyn Sinard  
Marilyn Sinard, Notary Public