


STATE OF KANSAS
STATE CORPORATION COMMISSION

Form CP-4

WELL PLUGGING RECORD

Give All Information Completely
Make Required Affidavit
Mail or Deliver Report to:
Conservation Division
State Corporation Commission
P. O. Box 17027
Wichita, Kansas 67217
NORTH

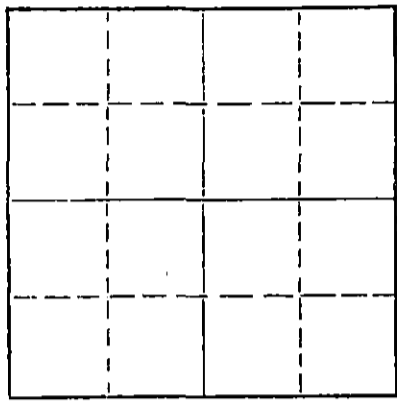

Locate well correctly on above Section Plat

HODGEMAN County, Sec. 18 Twp. 22S Rge. (E)24 (W)
Location as "NE/CNW/SW" or footage from lines C NW SE
Lease Owner Okmar Oil Company
Lease Name Cavanaugh Well No. 1
Office Address 1130 Vickers-KSB&T Bldg., Wichita, Kansas
Character of Well (completed as Oil, Gas or Dry Hole) Dry Hole
Date well completed July 23 1973
Application for plugging filed July 23 1973
Application for plugging approved July 23, 1973
Plugging commenced July 23, 1973
Plugging completed July 23, 1973
Reason for abandonment of well or producing formation
No commercial quantities of oil or gas encountered
If a producing well is abandoned, date of last production 19
Was permission obtained from the Conservation Division or its agents before plugging was commenced? Yes

Name of Conservation Agent who supervised plugging of this well Edgar J. Eves
Producing formation _____ Depth to top _____ Bottom _____ Total Depth of Well 4660 Feet
Show depth and thickness of all water, oil and gas formations.

OIL, GAS OR WATER RECORDS

CASING RECORD

FORMATION	CONTENT	FROM	TO	SIZE	PUT IN	PULLED OUT
Surface hole	water	Surface	247	8-5/8"	239	none

Describe in detail the manner in which the well was plugged, indicating where the mud fluid was placed and the method or methods used in introducing it into the hole. If cement or other plugs were used, state the character of same and depth placed, from _____ feet to _____ feet for each plug set.

- Plug 800' - 80 sacks cement
- Plug 240' - 30 sacks cement
- Mud to 45' - 1/2 sack hulls
- Plug 45' - 15 sacks cement

7-26-73

RECEIVED
STATE CORPORATION COMMISSION
JUL 26 1973
CONSERVATION DIVISION
Wichita, Kansas

(If additional description is necessary, use BACK of this sheet)
Name of Plugging Contractor D N B DRILLING, INC.
Address 701 First National Building, Wichita, Kansas 67202

STATE OF KANSAS, COUNTY OF SEDGWICK, ss.
James L. Donaldson (employee of owner) or (owner or operator) of the above-described well, being first duly sworn on oath, says: That I have knowledge of the facts, statements, and matters herein contained and the log of the above-described well as filed and that the same are true and correct. So help me God.

(Signature) James L. Donaldson
(Address)

SUBSCRIBED AND SWORN TO before me this 25th day of July, 1973

Ella Press
STATE NOTARY PUBLIC
Sedgwick County, Kansas
My Com. Expires Aug. 25, 1976

Ella Press
Notary Public.

My commission expires

DRILLERS' LOG

OKMAR OIL COMPANY
 No. 1 Cavanaugh
 C NW SE Sec. 18-22S-24W
 Hodgeman County, Kansas

Commenced: 7-13-73
 Completed: 7-23-73

Elevation: 2487 K. B.

Surface Casing: 239' of
 8-5/8" cemented w/175 sx
 cement, 3% cc. 7-13-73

<u>FORMATION</u>	<u>DEPTH</u>
Surface Hole	0 - 247
Shale and Sand	247 - 1065
Blaine Anhydrite	1065 - 1080
Shale and Sand	1080 - 1105
Shale	1105 - 1165
Sand	1165 - 1350
Shale	1350 - 1668
Stone Carral Anhydrite	1668 - 1700
Shale	1700 - 1740
Shale and Lime	1740 - 2500
Lime and Shale	2500 - 4160
Lime	4160 - 4660 T. D.

I do hereby certify that the foregoing statements are true and correct to the best of my knowledge and belief.

D N B DRILLING, INC.

James L. Donelson
 James L. Donelson

RECEIVED
 STATE CORPORATION COMMISSION
 DEC 21 1973
 CONSERVATION DIVISION
 Wichita, Kansas

STATE OF KANSAS: ss

Subscribed and sworn to before me, the undersigned, a Notary Public in and for said State, this 24th day of July, 1973.

Ella Priess

Ella Priess, Notary

Ella Priess
 STATE NOTARY PUBLIC
 Sedgwick County, Kansas
 My Com. Expires Aug. 25, 1976