

STATE OF KANSAS STATE CORPORATION COMMISSION


WELL PLUGGING RECORD

Give All Information Completely Make Required Affidavit Mail or Deliver Report to: Conservation Division State Corporation Commission 212 No. Market Wichita, Kansas

Hodgeman County, Sec. 16 Twp. 22S Rge. (E) 24 (W)

Location as "NE/CNW/SW" or footage from lines C SE SE Lease Owner: Beacon Resources Corporation Lease Name: Shriwise Well No. 1 Office Address: 1000 Century Plaza, Wichita, Kansas 67202 Character of Well (completed as Oil, Gas or Dry Hole) Dry Hole Date well completed October 29, 1969 Application for plugging filed 19 Application for plugging approved 19 Plugging commenced October 29, 1969 Plugging completed October 29, 1969 Reason for abandonment of well or producing formation Dry Hole

NORTH

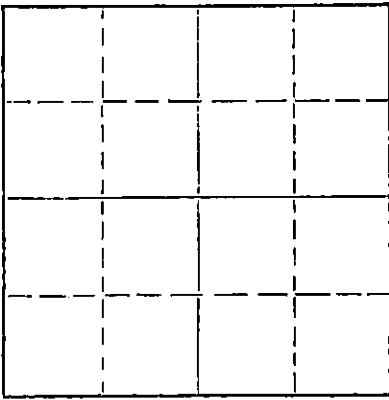

Locate well correctly on above Section Plat

If a producing well is abandoned, date of last production 19 Was permission obtained from the Conservation Division or its agents before plugging was commenced? Yes (Edgar J. Eves of Sublette)

Name of Conservation Agent who supervised plugging of this well Producing formation Depth to top Bottom Total Depth of Well 4765 Feet Show depth and thickness of all water, oil and gas formations.

OIL, GAS OR WATER RECORDS

CASING RECORD

Table with 7 columns: FORMATION, CONTENT, FROM, TO, SIZE, PUT IN, PULLED OUT. Row 1: Surface, 0, 1117', 8-5/8", 1117', None. Row 2: Casing.

Describe in detail the manner in which the well was plugged, indicating where the mud fluid was placed and the method or methods used in introducing it into the hole. If cement or other plugs were used, state the character of same and depth placed, from feet to feet for each plug set.

Plug and 30 sax from Total Depth to 1100 Feet; Mud to 40 feet, 1/2 sax Halls, Plug Bridged and 15 sax Cement to Base of Cellar; 2 sax Cement in Rat Hole. Job Completed @ 13:45 P.M. on 10/29/69.

RECEIVED STATE CORPORATION COMMISSION OCT 31 1969 CONSERVATION DIVISION Wichita, Kansas

(If additional description is necessary, use BACK of this sheet)

Name of Plugging Contractor: Sage Drilling Co., Inc. Address: 500 Bitting Building, Wichita, Kansas 67202

STATE OF KANSAS, COUNTY OF SEDGWICK, ss. T. M. McCaul, Jr. of Sage Drilling Co. (employee of owner) or (owner or operator) of the above-described well, being first duly sworn on oath, says: That I have knowledge of the facts, statements, and matters herein contained and the log of the above-described well as filed and that the same are true and correct. So help me God. (Signature) T. M. McCaul

500 Bitting Building, Wichita, Kansas 67202 (Address)

Subscribed and sworn to before me this 30th day of October, 1969

Wayne W. Kahmeyer Notary Public

My commission expires August 22, 1972.



DRILLERS LOG

SHRIWISE NO. 1

CASING RECORD:	OPERATOR:	Beacon Resources Corporation	DESCRIPTION:
8-5/8" @ 1117'	CONTRACTOR:	Sage Drilling Co., Inc.	C SE SE
w/550 sax cement	COMMENCED:	October 18, 1969	Sec. 16-22S-24W
TOTAL DEPTH:	COMPLETED:	October 28, 1969	Hodgeman Co., Kansas
4765'			ELEVATION: 2482 KB

<u>FORMATION</u>	<u>FROM</u>	<u>TO</u>	<u>REMARKS</u>
Shale	0	475	<p>RECEIVED STATE CORPORATION COMMISSION OCT 31 1969 CONSERVATION DIVISION Wichita, Kansas</p> <p>D&A</p>
D-Sand	475	545	
Shale	545	855	
Shale & Red Bed	855	1113	
Blaine Anhydrite	1113	1117	
Red Bed, Shale & Sand	1117	1665	
Shale	1665	2115	
Shale & Lime	2115	2600	
Lime & Shale	2600	4668	
Lime & Conglomerate	4668	4720	
Mississippian Dolomite	4720	4745	
Mississippian Lime	4745	4765	

I certify that this is a true and correct copy of the above log to the best of my knowledge.

SAGE DRILLING CO., INC.

By T. M. McCaul, Jr.

Subscribed and sworn to before me this 30th day of October, 1969.

Wayne W. Kahmeyer
Wayne W. Kahmeyer, Notary Public

