

STATE OF KANSAS  
STATE CORPORATION COMMISSION


WELL PLUGGING RECORD

Give All Information Completely  
Make Required Affidavit  
Mail or Deliver Report to  
Conservation Division  
State Corporation Comm.  
245 North Water  
Wichita, KS 67202

Hodgeman County, Sec. 16 Twp. 22S Rge. 24 XE/W  
Location as "NE/CNW 1/4 SW 1/4" or footage from lines

C SW NE  
Lease Owner Petro - Gas Energies  
Lease Name Schriwise # 1 Well No. 1

Office Address 411 Farmers & Bankers Bldg.; Wichita, KS  
Character of Well (Completed as Oil, Gas or Dry Hole) 67202

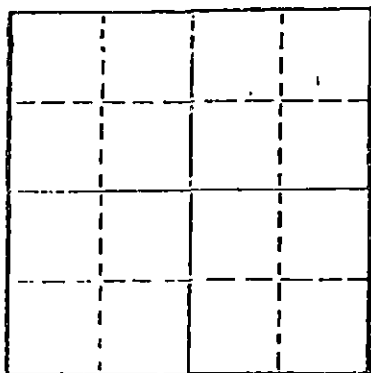

Locate well correctly on above  
Section Plot

DRY HOLE  
Date Well completed January 3, 1981  
Application for plugging filed January 3, 1981  
Application for plugging approved January 3, 1981  
Plugging commenced January 3, 1981  
Plugging completed January 3, 1981  
Reason for abandonment of well or producing formation

DRY HOLE  
If a producing well is abandoned, date of last production 19

Was permission obtained from the Conservation Division or  
its agents before plugging was commenced? Yes

Name of Conservation Agent who supervised plugging of this well Clarence Thomas, Jr.  
Producing formation Depth to top Bottom Total Depth of Well  
Show depth and thickness of all water, oil and gas formations.

OIL, GAS OR WATER RECORDS

CASING RECORD

FORMATION	CONTENT	FROM	TO	SIZE	PUT IN	PULLED OUT
		0	610	8 5/8	608	0

Describe in detail the manner in which the well was plugged, indicating where the mud fluid was placed and the method or methods used in introducing it into the hold. If cement or other plugs were used, state the character of same and depth placed, from feet to feet for each plug set.

60 Sacks @ 900' 50-50 Poz 6% Gel  
35 Sacks @ 630' " " "  
10 Sacks @ 40' " " "  
5 Sacks in Rathole  
5 Sacks in Mousehole  
Plugged down at 1:15 P.M. January 3, 1981

(If additional description is necessary, use BACK of this sheet)

Name of Plugging Contractor Blue Goose Drilling Co., Inc.

STATE OF KANSAS COUNTY OF BARTON, ss.  
George E. Miller, Jr. (XXXXXXXXXXXXXXXXXXXX) or (owner or operator)  
of the above-described well, being first duly sworn on oath, says: That I have knowledge of the facts, statements, and matters herein contained and the log of the above-described well as filed and that the same are true and correct. So help me God.


(Signature) George E. Miller, Jr.  
P.O. Box 1413 Great Bend, KS 67530  
(Address)

SUBSCRIBED AND SWORN TO before me this 7th day of January, 1981

Helen C. Standley  
Notary Public.

My commission expires December 8, 1983

RECEIVED  
STATE CORPORATION COMMISSION

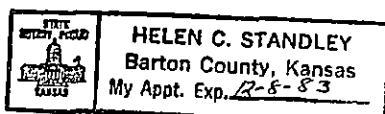

JAN 12 1981  
1-12-81  
CONSERVATION DIVISION  
Wichita, Kan.

## WELL LOG

SCHRIWISE # 1  
C SW NE Sec 16-22S-24W  
Hodgeman County, Kansas

NAME OF OPERATOR: Petro - Gas Energies  
411 Farmers & Bankers Building  
Wichita, Kansas 67202


DATE COMPLETED: January 3, 1981

FROM	TO	
2300	2305	Shale & Sand
2305	2595	Shale
2595	2800	Shale & Lime
2800	3269	Shale
3269	3650	Shale & Lime
3650	3908	Shale, Lime & Sand
3908	4548	Shale & Lime
4548	4593	Lime
4593	4740	Lime & Shale
4750		T.D.


STATE OF KANSAS


COUNTY OF BARTON ss

George E. Miller, Jr., President of Blue Goose Drilling Co., Inc., being first duly sworn on oath says: That I have knowledge of the facts, statements and matters herein contained and the log of the above described well as filed and that the same are true and correct.

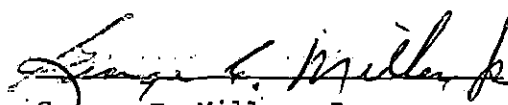  
George E. Miller, Jr.

Subscribed and sworn before me this 7th day of January, 1981

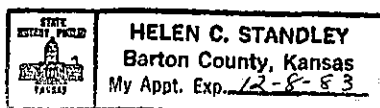

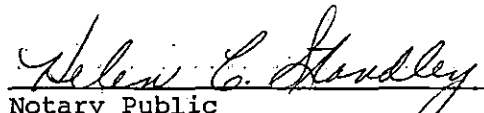  
Notary Public

My Commission Expires: 12-8-83

RECEIVED  
STATE CORPORATION COMMISSION

JAN 12 1981

CONSERVATION DIVISION  
Wichita, Kansas