

WELL PLUGGING RECORD

Give All Information Completely
Make Required Affidavit
Mail or Deliver Report to:
Conservation Division
State Corporation Commission
211 No. Broadway
Wichita, Kansas

Hodgeman

County. Sec. 8 Twp. 22S Rge. 21 (E) W (W)

Location as "NE/CNWxSWx" or footage from lines NE/4 SE/4

Lease Owner Pan American Petroleum Corporation

Lease Name Lydia Morris Well No. 1

Office Address Box 507, Ulysses, Kansas

Character of Well (completed as Oil, Gas or Dry Hole) Dry Hole

Date well completed 9-16 19.63

Application for plugging filed 9-16 19.63

Application for plugging approved 9-16 19.63


Plugging commenced 9-16 19.63

Plugging completed 9-16 19.63

Reason for abandonment of well or producing formation No commercial quantities of oil or gas present

If a producing well is abandoned, date of last production None 19.

Was permission obtained from the Conservation Division or its agents before plugging was commenced? Yes

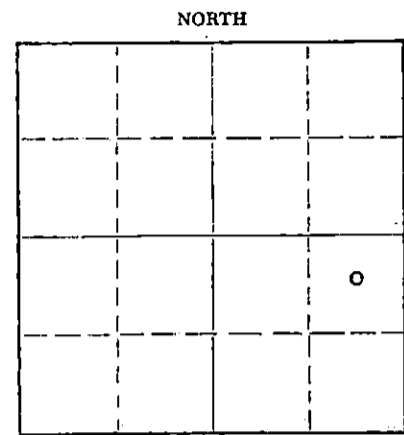

Locate well correctly on above Section Plot

Name of Conservation Agent who supervised plugging of this well Mr. Hugh Scott

Producing formation _____ Depth to top _____ Bottom _____ Total Depth of Well 4525 Feet

Show depth and thickness of all water, oil and gas formations.

OIL, GAS OR WATER RECORDS

CASING RECORD

FORMATION	CONTENT	FROM	tops	SIZE	PUT IN	PULLED OUT
Chase			2284	8-5/8	1066	None
Council Grove			2648			
Topeka			3348			
Missouri			3782			
Des Moines			4153			
Mississippian			4402			

Describe in detail the manner in which the well was plugged, indicating where the mud fluid was placed and the method or methods used in introducing it into the hole. If cement or other plugs were used, state the character of same and depth placed, from _____ feet to _____ feet for each plug set.

4525 - 700 Heavy mud
700 - 600 35 sacks cement
600 - 40 Heavy mud
40 - bottom cellar Dumped 1/2 sack hulls, set Howco plug and placed 15 sacks cement

RECEIVED
STATE CORPORATION COMMISSION

SEP 30 1963

CONSERVATION DIVISION
Wichita, Kansas

9-30-63

(If additional description is necessary, use BACK of this sheet)

Name of Plugging Contractor Sierra Petroleum Company, Inc.

Address 208 Petroleum Bldg., Wichita, Kansas

STATE OF Kansas, COUNTY OF Grant, ss.
D. M. Liles (employee of owner) or (owner or operator) of the above-described

well, being first duly sworn on oath, says: That I have knowledge of the facts, statements, and matters herein contained and the log of the above-described well as filed and that the same are true and correct. So help me God.

(Signature) [Signature] -Area Supt.

Box 507, Ulysses, Kansas (Address)

SUBSCRIBED AND SWORN TO before me this 20 day of September 1963

My commission expires 12-3-64

[Signature] R. W. Banks Notary Public.