

STATE OF KANSAS
STATE CORPORATION COMMISSION

WELL PLUGGING RECORD


OR

FORMATION PLUGGING RECORD

Strike out upper line
when reporting plugging
off formations.

Give All Information Completely
Make Required Affidavit
Mail or Deliver Report to:
Conservation Division
State Corporation Commission
800 Bittling Building
Wichita, Kansas

NORTH

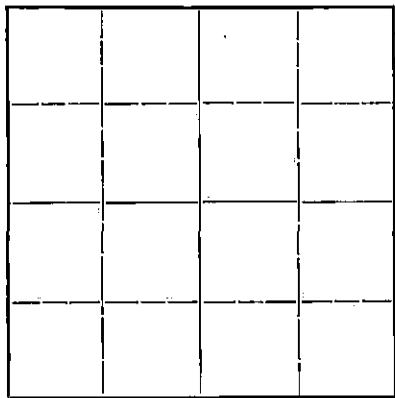

Locate well correctly on above
Section Plat

Pawnee County, Sec. 16 Twp. 22 Rge. (E) 20 (W)
Location as "NE 1/4 NW 1/4 SW 1/4" or footage from lines. NW/4 NE/4 NW/4
Lease Owner Adair-Morton Company
Lease Name Thompson Well No. 1
Office Address Wheeler-Kelly-Haggy Building, Wichita, Kansas
Character of Well (completed as Oil, Gas or Dry Hole) Dry Hole
Date well completed May 14, 19 42
Application for plugging filed May 13 19 42
Application for plugging approved May 13 19 42
Plugging commenced May 14 19 42
Plugging completed May 14 19 42
Reason for abandonment of well or producing formation No shows

If a producing well is abandoned, date of last production 19
Was permission obtained from the Conservation Division or its agents before plugging was commenced? Yes

Name of Conservation Agent who supervised plugging of this well C. T. Alexander
Producing formation Depth to top Bottom Total Depth of Well 5012 Feet
Show depth and thickness of all water, oil and gas formations.


OIL, GAS OR WATER RECORDS

CASING RECORD

Formation	Content	From	To	Size	Put In	Pulled Out
				13"	160	None

Describe in detail the manner in which the well was plugged, indicating where the mud fluid was placed and the method or methods used in introducing it into the hole. If cement or other plugs were used, state the character of same and depth placed, from feet to feet for each plug set.

Filled with mud 5012 feet to 300 feet, bridged with cement 300 feet to 275 feet, filled with mud 275 feet to 26 feet, cement from 26 feet to 6 feet. Filled with mud to surface.

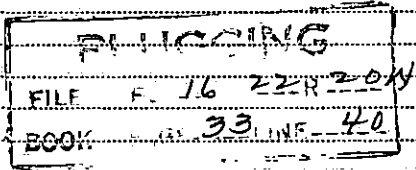

(If additional description is necessary, use BACK of this sheet)

Correspondence regarding this well should be addressed to Adair-Morton Company
Address Wheeler-Kelly-Haggy Building, Wichita, Kansas

5-16-42

STATE OF Kansas, COUNTY OF Sedgwick, ss.
G. H. Hannum (employee of owner) or (owner or operator) of the above-described well,
being first duly sworn on oath, says: That I have knowledge of the facts, statements, and matters herein contained and the log of the above-described well as filed and that the same are true and correct. So help me God.

(Signature)

G. H. Hannum

(Address)

SUBSCRIBED AND SWORN to before me this 15 day of May, 19 42

Clytell Smalley
Notary Public.

My commission expires December 6, 1945



COMPANY: Adair-Morton Company
 CONTRACTOR: Hannum Drilling Company, Inc.
 FARM: Thompson Well No. 1

LOCATION: o NW/4 NE/4 NW/4
 Sec. 16-22-20W.,
 Pawnee County, Kansas

COMMENCED: April 12, 1942
 COMPLETED: May 14, 1942

CASING RECORD

ELEVATION: 2199 13" 160' - 150' sax cement
 PRODUCTION: D & A

FORMATION	DEPTH	FORMATION	DEPTH
surface sand & clay	20	broken lime	3496
shale & hard sand	152	lime	3635
shale & lime shells	168	shale	3647
shale & shells	190	lime	3758
sand & shale streaks	240	broken lime	3783
shale & shells	350	lime	3800
sand	365	shale	3838
shale & shells	440	lime	3930
redrock & shale	530	oolitic lime - cherty	3960
redrock, shale & pyrite shells	590	lime	4160
redrock, pyrite & streaks		lime & shale	4346
of Anhydrite	635	Conglomerate - cherty	4425
Anhydrite, Gyp & shale	655	white chert	4492
redrock, shale & gyp	735	shale & chert	4600
redrock & sand	945	lime	4646
redrock with trace of gyp	975	lime & chert	4761
redrock & gyp	1000	sand & green shale	4770
redrock W/gyp & sand streaks	1135	Dolomite & shale	4837
redrock & shale	1295	cherty lime	4855
Anhydrite	1340	chert	4858
redrock & shale	1475	Dolomite	5012
shale & redrock (hard streak)	1590		
redrock, shale & shells	1620	TOTAL DEPTH	
sandy lime	1645		
shale & shells	1765	Top Anhydrite	1285
shale & shells W/redrock	2090	Top Topeka	3385
shale & hard lime	2125	Top Lansing	3840
Anhydrite	2282	Top Mississippi	4425
brown lime	2300	Top Kinderhook	4484
lime	2385	Top Cherty Conglomerate	4545
broken lime	2450	Top Cherty Viola	4600
lime	2510	Top Simpson	4953
lime & hard sand	2575	Top Arbuckle	4960
shale & shells	2680		
broken lime	2720		
broken lime & shale	2810		
broken lime	2950		
broken lime & shale	2990		
shale & shells	3045		
broken lime	3335		
lime & shale	3395		



I hereby certify this to be a correct and accurate log of the above described well as shown by the drilling reports.

D. M. Hannum

Subscribed and sworn to before me this 15 day of May, 1942

C. J. Small
 Notary Public

My Commission expires: December 6, 1945

PLUGGING

FILE # 16-22-R20W
 BOOK PAGE 33 LINE 40