


Give All Information Completely
Make Required Affidavit
Mail or Deliver Report to:
Conservation Division
State Corporation Commission
211 No. Broadway
Wichita, Kansas

WELL PLUGGING RECORD

Pawnee County, Sec. 13 Twp. 22S Rge. 20W (E) (W)
Location as "NE/CNW%SW%" or footage from lines C NW NW
Lease Owner Adair Oil Company
Lease Name Ruby Well No. 1
Office Address 1005 East Second, Wichita, Kansas
Character of Well (completed as Oil, Gas or Dry Hole) D & A
Date well completed December 5 19 63
Application for plugging filed December 5 19 63
Application for plugging approved December 5 19 63
Plugging commenced December 5 19 63
Plugging completed December 5 19 63
Reason for abandonment of well or producing formation D & A

NORTH

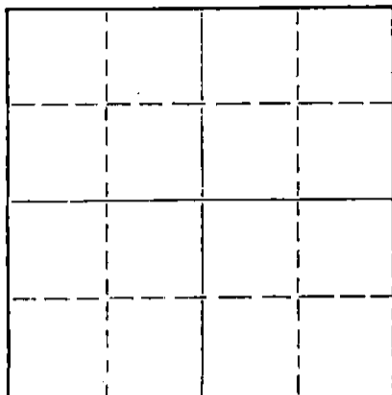

Locate well correctly on above
Section Plat

If a producing well is abandoned, date of last production 19
Was permission obtained from the Conservation Division or its agents before plugging was commenced? Frank Broadfoot

Name of Conservation Agent who supervised plugging of this well _____
Producing formation _____ Depth to top _____ Bottom _____ Total Depth of Well 4415 Feet
Show depth and thickness of all water, oil and gas formations.

OIL, GAS OR WATER RECORDS

CASING RECORD

FORMATION	CONTENT	FROM	TO	SIZE	PUT IN	PULLED OUT
				8 5/8"	307 1/2	-0-

Describe in detail the manner in which the well was plugged, indicating where the mud fluid was placed and the method or methods used in introducing it into the hole. If cement or other plugs were used, state the character of same and depth placed, from _____ feet to _____ feet for each plug set.

Filled hole w/mud. Pushed plug down to 300'. Cemented with 50 sacks. Set plug @ 50' w/15 sx. 5 sacks in rathole.

RECEIVED
STATE CORPORATION COMMISSION

DEC 16 1963

12-16-68

CONSERVATION DIVISION
Wichita, Kansas

(If additional description is necessary, use BACK of this sheet)

Name of Plugging Contractor Red Tiger Drilling Company
Address Box 173-Russell, Kans.

STATE OF KANSAS COUNTY OF SEDGWICK, ss.
George A. Angle (employee of owner or operator) of the above-described well, being first duly sworn on oath, says: That I have knowledge of the facts, statements, and matters herein contained and the log of the above-described well as filed and that the same are true and correct. So help me God.

(Signature) George A. Angle
1720 Wichita Plaza, Wichita, Kansas
(Address)

SUBSCRIBED AND SWORN TO before me this 9th day of December, 1963

My commission expires 11-17-66

Maxine V. Head
Notary Public.

DRILLERS LOG

No. 1 Ruby

CASING RECORD: 8 5/8" @ 307 1/2' w/275 sx cement
 COMPANY: Adair Oil Company
 CONTRACTOR: Red Tiger Drilling Co.
 COMMENCED: November 26, 1963
 DESCRIPTION: C NW NW
 13-22S-20W
 Pawnee Co., Kansas
 TOTAL DEPTH: 4415' COMPLETED: December 5, 1963
 ELEVATION: 2129 DF
 2132 RB

<u>FORMATION</u>	<u>FROM</u>	<u>TO</u>	<u>REMARKS</u>
Clay	0	70	
Sand & Shale	70	312	
Shale Shells & Redbed	312	596	
Anhydrite	596	610	
Shale & Shells	610	700	
Sand	700	830	
Shale & Shells	830	1270	
Anhydrite	1270	1295	
Shale Shells & Redbed	1295	1575	
Shale & Shells	1575	2058	
Shale & Lime	2058	3815	
Lime	3815	4369	
Chert & Lime	4369	4415	

RECEIVED
 STATE CORPORATION COMMISSION
 DEC 16 1963
 CONSERVATION DIVISION
 Wichita, Kansas

I certify that this is a true and correct copy of the above log to the best of my knowledge.

RED TIGER DRILLING COMPANY

George A. Angle
 George A. Angle

Subscribed and sworn to before me this 9th day of December, 1963.

Dwayne V. Head
 Notary Public

My Commission Expires:

11-17-66