


Give All Information Completely
Make Required Affidavit
Mail or Deliver Report to:
Conservation Division
State Corporation Commission
211 No. Broadway
Wichita, Kansas

WELL PLUGGING RECORD

Pawnee County, Sec. 9 Twp. 22S Rge. 20W ~~(E)~~ (W)

Location as "NE/CNW%SW%" or footage from lines SW NW SE
Lease Owner D. R. Lauck Oil Company, Inc.
Lease Name Bryant Well No. 1
Office Address 301 S. Broadway, Wichita, Kansas
Character of Well (completed as Oil, Gas or Dry Hole) Dry Hole
Date well completed August 20, 19 61
Application for plugging filed August 20, 19 61
Application for plugging approved August 20, 19 61
Plugging commenced August 20, 19 61
Plugging completed August 20, 19 61
Reason for abandonment of well or producing formation Dry Hole

NORTH

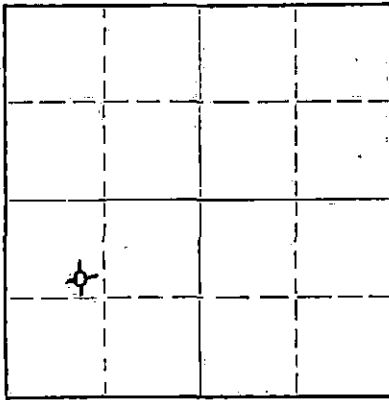

Locate well correctly on above
Section Plat

If a producing well is abandoned, date of last production -- 19 --
Was permission obtained from the Conservation Division or its agents before plugging was commenced? Yes

Name of Conservation Agent who supervised plugging of this well Frank Broadfoot
Producing formation -- Depth to top -- Bottom -- Total Depth of Well 4500 Feet
Show depth and thickness of all water, oil and gas formations.

OIL, GAS OR WATER RECORDS

CASING RECORD

FORMATION	CONTENT	FROM	TO	SIZE	PUT IN	PULLED OUT
		0	390'	8-5/8"	390'	None

Describe in detail the manner in which the well was plugged, indicating where the mud fluid was placed and the method or methods used in introducing it into the hole. If cement or other plugs were used, state the character of same and depth placed, from feet to feet for each plug set.

Mud 4500' - 240'
Plug 240' - 236'
Cement (20 sacks) 236' - 200'
Mud 200' - 35'
Plug 35' - 31'
Cement (10 sacks) 31' - 6' (Bottom of Cellar)

9-5-61
STATE CORPORATION COMMISSION
SEP 5 1961
CONSERVATION DIVISION
Wichita, Kansas

(If additional description is necessary, use BACK of this sheet)

Name of Plugging Contractor Sun Cementing Company
Address Great Bend, Kansas

STATE OF KANSAS, COUNTY OF SEDGWICK, ss.
John H. Knightley (employee of owner) or (owner or operator) of the above-described well, being first duly sworn on oath, says: That I have knowledge of the facts, statements, and matters herein contained and the log of the above-described well as filed and that the same are true and correct. (So help me God.)

(Signature) John H. Knightley
301 S. Broadway, Wichita, Kansas
(Address)

SUBSCRIBED AND SWORN to before me this 1st day of September, 19 61.

My commission expires March 12, 1963

Stella J. Bodine
Notary Public.

D. R. Lauck Oil Company, Inc.

Bryant #1

SW NW SE Sec. 9-22S-20W
Pawnee County, KansasCommenced: August 8, 1961
Completed: August 20, 1961Casing Record: 309' 8-5/8" Cemented w/210 sacks cement,
4 sacks Calcium Chloride.

Elevation: GR 2176; DF 2178; KB 2180.

Drillers Log

Tops

		Sample	Welex
Surface Clay	75		
Shale	425	Heebner	3688-1508 3687-1507
Red Bed	700	Toronto	3704-1524 3704-1524
Sand	840	Douglas	3718-1538 3734-1554
Red Bed	1260	Lansing-Kansas City	3756-1576 3756-1576
Anhydrite	1290	Base Kansas City	4086-1906
Red Bed	1380	Marmaton	4104-1924 4109-1924
Red Bed & Shale	1450	Cherokee Shale	4254-2074 4255-2075
Shale & Shells	1910	Mississippian	4347-2167 4346-2166
Anhydrite	2110	Total Depth	4500-2320 4501-2321
Lime & Shale	2395		
Lime & Pyrite	2525		
Shale & Lime	2655	DST #1 (M) 3647-3714, open 1 hr. w/weak blow thruout. Recovered 503' muddy salt water.	
Lime & Shale	2880	BHP 1202# 30 min.	
Shale & Lime	3335	IFP 111#	
Lime & Shale	3620	FFP 290#	
Lime	3685		
Shale & Heebner	3692	DST #2 (H) 4307-4370, open 1 hr. w/strong blow thruout. Gas to surface in 15 min. too small to measure. Recovered 130' gas cut mud.	
Lime & Shale	3800	ISIP 680# 30 min. (still building)	
Lime	4230	FSIP 300# 30 min. (still building)	
Shale	4250	IFP 58#	
Lime	4295	FFP 65#	
Lime, Shale & Sand	4347		
Shale & Chert	4370	DST #3 (H) 4373-4395, open 1 hr. w/weak blow 30 min. & died. Recovered 65' mud.	
Chert	4420	ISIP 920# 30 min.	
Lime & Shale	4454	FSIP 95# 30 min.	
Shale, Lime & Chert	4496	IFP 50#	
Chert	4500 RTD	FFP 50#	
		DST #4 (M) 4411-4420, open 1 hr. w/weak blow thruout. Recovered 65' slightly oil specked mud.	
		ISIP 905# 30 min. (still building)	
		FSIP 125# 30 min. (still building)	
		IFP 20#	
		FFP 40#	

RECEIVED
STATE CORPORATION COMMISSION
SEP 5 1961
CONSERVATION DIVISION
Wichita, Kansas