

STATE OF KANSAS
STATE CORPORATION COMMISSION

WELL PLUGGING RECORD

Give All Information Completely
Make Required Affidavit
Mail or Deliver Report to
Conservation Division
State Corporation Comm.
245 North Water
Wichita, KS 67202

Pawnee County, Sec. 9 Twp 22S Rge 20W E/W
Location as "NE/CNW $\frac{1}{2}$ SW $\frac{1}{2}$ " or footage from lines NE NE NW

Lease Owner Energy Service Corp., & Theodore Leben, an individual
Lease Name SMITH Well No. 1

Office Address 210 Petroleum Bldg, Wichita, KS 67202

Character of Well (Completed as Oil, Gas or Dry Hole) Dry Hole

Date Well completed 9-19-79 19

Application for plugging filed 9-19-79 19

Application for plugging approved 9-19-79 19

Plugging commenced 9-19-79 19

Plugging completed 9-19-79 19

Reason for abandonment of well or producing formation Dry Hole


If a producing well is abandoned, date of last production 19

Was permission obtained from the Conservation Division or its agents before plugging was commenced? YES

Name of Conservation Agent who supervised plugging of this well Marion Schmidt

Producing formation _____ Depth to top _____ Bottom _____ Total Depth of Well 4470'

Show depth and thickness of all water, oil and gas formations.

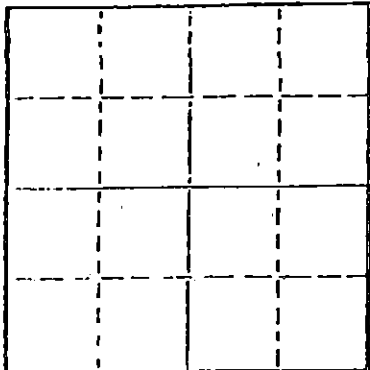

Locate well correctly on above Section Plat

OIL, GAS OR WATER RECORDS

CASING RECORD

| FORMATION | CONTENT | FROM | TO | SIZE | PUT IN | PULLED OUT |
|-----------|---------|------|----|--------|--------|------------|
| | | | | 8-5/8" | 278 | none |
| | | | | | | |
| | | | | | | |
| | | | | | | |

Describe in detail the manner in which the well was plugged, indicating where the mud fluid was placed and the method or methods used in introducing it into the hold. If cement or other plugs were used, state the character of same and depth placed, from _____ feet to _____ feet for each plug set.

1st plug @ 540' w/60 sx. of 60-40 posmix, 3% CC
2nd plug @ 270' w/30 sx. of 60-40 posmix, 3% CC
3rd plug @ 40' w/10 sx. of 60-40 posmix, 3% CC
5 sx. in the rat hole.

STATE RECEIVED 10-17-79
STATE CORPORATION COMMISSION
OCT 17 1979
CONSERVATION DIVISION
Wichita, Kansas

(If additional description is necessary, use BACK of this sheet)

Name of Plugging Contractor Murfin Drilling Company

STATE OF KANSAS COUNTY OF SEDGWICK, ss.
Wm. S. Shropshire, Asst. Gen. Mgr. of Murfin Drilg. (employee of owner) or (owner or operator) of the above-described well, being first duly sworn on oath, says: That I have knowledge of the facts, statements, and matters herein contained and the log of the above-described well as filed and that the same are true and correct. So help me God.

(Signature) Wm. S. Shropshire
Wm. S. Shropshire, Asst. Gen. Mgr.
617 Union Center Building, Wichita, KS 67202 (Address)

SUBSCRIBED AND SWORN TO before me this 16th day of October, 1979

My commission expires May 21, 1983

Linda Lynch
Linda Lynch Notary Public.




WELL LOG

COMPANY Energy Service Corporation, and Theodore Leben, as an individual
FARM SMITH NO. 1

SEC. 9 T. 22S R. 20W
LOC. NE NE NW

RIG. NO. 19
TOTAL DEPTH 4470'
COMM. 9-4-79 COMP. 9-19-79
CONTRACTOR Murfin Drilling Company

COUNTY Pawnee County, KANSAS

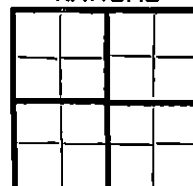

CASING
20 10
15 8 -5/8" csg. set @ 278' w/ 200' sx. of common, ELEVATION
12 6 2% gel, 3% CC.
13 5 PRODUCTION

FIGURES INDICATE BOTTOM OF FORMATIONS

278' Shale
606' Shale (Red Bed)
668' Red Bed
730' Shale (Red Bed)
880' Sand
1136' Red Bed
1622' Shale
1715' Shale & Lime
2080' Shale
2205' Lime & Shale
2460' Lime
2830' Lime & Shale
2990' Lime
3780' Lime & Shale
4402' Lime
4427' Chert
4470' Lime & Chert. R T D

RECEIVED
STATE CORPORATION COMMISSION
OCT 17 1979
CONSERVATION DIVISION
Wichita, Kansas

State of KANSAS
County of SEDGWICK ss:

Wm. S. Shropshire, Asst. Gen. Mgr. of the Murfin Drilling Company Company

upon oath state that the above and foregoing is a true and correct copy of the log of the SMITH #1 well.

Wm. S. Shropshire
Wm. S. Shropshire, Asst. Gen. Mgr.

Subscribed and sworn to before me this 16th day of October 19 79

Linda Lynch
Linda Lynch NOTARY PUBLIC

My Commission Expires:

