


WELL PLUGGING RECORD

Give All Information Completely  
Make Required Affidavit  
Mail or Deliver Report to:  
Conservation Division  
State Corporation Commission  
800 Bitting Building  
Wichita, Kansas

NORTH

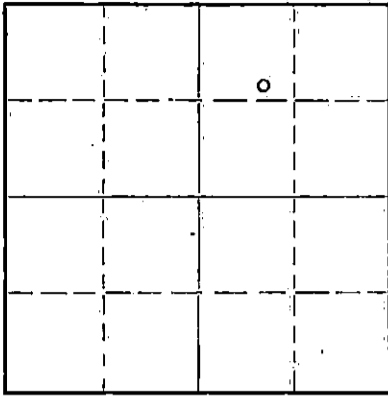

Locate well correctly on above  
Section Plat

Pawnee County Sec. 32 Twp. 22 Rge. 20 (W) (E)  
Location as "NE/CNW $\frac{1}{4}$ /SW $\frac{1}{4}$ " or footage from lines SW NW NE  
Lease Owner D. E. Dunne, Jr.  
Lease Name Nolde Well No. 1  
Office Address 1005 Central Building, Wichita, Kansas  
Character of Well (completed as Oil, Gas or Dry Hole) Dry Hole  
Date well completed 12-14 1957  
Application for plugging filed 12-19 1957  
Application for plugging approved 12-17 1957  
Plugging commenced 12-15 1957  
Plugging completed 12-15 1957  
Reason for abandonment of well or producing formation Dry Hole  
If a producing well is abandoned, date of last production 19  
Was permission obtained from the Conservation Division or its agents before plugging was commenced? Yes

Name of Conservation Agent who supervised plugging of this well Frank Broadfoot, 222 S. Main, St. John, Kansas  
Producing formation Depth to top Bottom Total Depth of Well 461.5 Feet  
Show depth and thickness of all water, oil and gas formations.

OIL, GAS OR WATER RECORDS

CASING RECORD

Formation	Content	From	To	Size	Put In	Pulled Out

Describe in detail the manner in which the well was plugged, indicating where the mud fluid was placed and the method or methods used in introducing it into the hole. If cement or other plugs were used, state the character of same and depth placed, from \_\_\_\_\_ feet to \_\_\_\_\_ feet for each plug set.

Set plug at 210'. Pour 20 sacks mixed Cement through  
drill pipe on plug. Fill hole to 35' of base of cellar with  
heavy mud. Set Plug and Cap with 10 sacks mixed cement.

**RECEIVED**  
STATE CORPORATION COMMISSION  
DEC 20 1957  
CONSERVATION DIVISION  
Wichita, Kansas

(If additional description is necessary, use BACK of this sheet)

Correspondence regarding this well should be addressed to D. E. Dunne, Jr.  
Address 1005 Central Building, Wichita, Kansas

STATE OF Kansas, COUNTY OF Sedgwick, ss.  
Almeda Day (employee of owner) or (owner or operator) of the above-described well,  
being first duly sworn on oath, says: That I have knowledge of the facts, statements, and matters herein contained and the log of the above-described well as filed and that the same are true and correct. So help me God.

(Signature) *Almeda Day*  
1005 Central Building, Wichita, Kansas (Address)

SUBSCRIBED AND SWORN to before me this 19 day of December, 1957.

My commission expires September 29, 1960

*James S. Hicks*  
Notary Public.

PLUGGING  
FILE SEC 32 T 22 R 206  
BOOK PAGE 69 LINE 38

WELL LOG

Well: Nolde #1  
 Location: SW NW NE  
 32-22S-20W  
 Pawnee County, Kansas

Commenced: 12-1-57  
 Completed: 12-14-57

Operator: D. E. Dunne, Jr.  
 1005 Central Building  
 Wichita, Kansas

Contractor: Twin Drilling, Inc.  
 1005 Central Building  
 Wichita, Kansas

Casing Record:  
 8 5/8" - 226' w/125 Sacks Cement

Surface	25	Lime	3727
Shale & Clay	110	Lime w/ Shale Brks	3826
Shale & Lime Shells	200	Lime	3878
Shale & Sand	212	(Heebner 3878')	
Shale & Lime	220	Shale Lime	3970
Lime	222	(Brown Lime 3961')	
Shale & Shells	510	(Lansing 3970')	
Shale & Red Bed	810	Lime	4466
Sand	940	Lime - Shale	4518
Shale	1000	(Mississippi 4518')	
Shale w/ Sand Streaks	1343	Mississippi Lime-Chert	4533
Shale & Sand	1370	Mississippi Lime	4565
Lime	1460	Lime Chert	4576
Shale & Lime	2330	Lime	4615 1/2
Anhydrite	2465	4615 1/2 R.T.D.	
Lime	2535		
Shale & Lime	2660	Dry Hole	
Lime	2980		
Lime & Shale	3136		
Lime	3155		
Lime & Shale	3404		
Lime Bk-Shale	3532		
Lime - Chalk	3570		

RECEIVED  
 CORPORATION COMMISSION  
 DEC 20 1957  
 VISION

STATE OF KANSAS )  
 ) ss.  
 COUNTY OF SEDGWICK )

The undersigned, TWIN DRILLING, INC., hereby certifies that the above log is a true and correct log of the formations encountered in drilling the above well as reflected by the Daily Drilling Report.

TWIN DRILLING, INC.

By Alameda Day  
 Secretary

Subscribed and sworn to before me this 19th day of December, 1957.

James A. Nichols  
 Notary Public

My commission expires September 29, 1960.

PLUGGING  
 SEC 32 T 22 R 20W  
 BOOK PAGE 69 LINE 38