


STATE OF KANSAS
STATE CORPORATION COMMISSION

WELL PLUGGING RECORD

Give All Information Completely
Make Required Affidavit
Mail or Deliver Report to
Conservation Division
State Corporation Comm.
245 North Water
Wichita, KS 67202

Hodgeman County. Sec. 24 Twp. 22 Rge. 24 NW
Location as "NE/CNW $\frac{1}{4}$ /SW $\frac{1}{4}$ " or footage from lines
C-W/2-SW/4-SW/4
Lease Owner L. G. Stephenson & Co., Inc.
Lease Name Bernard Springer Well No. #1
Office Address Suite 670, 7701 E. Kellogg, Wichita, Ks. 67207
Character of Well (Completed as Oil, Gas or Dry Hole)
Oil Well
Date Well completed 3-26 1977
Application for plugging filed 8-8 1979
Application for plugging approved 8-9 1979
Plugging commenced 8-20 1979
Plugging completed 8-20 1979
Reason for abandonment of well or producing formation
Depleted
If a producing well is abandoned, date of last production
June 1979
Was permission obtained from the Conservation Division or
its agents before plugging was commenced? yes
Name of Conservation Agent who supervised plugging of this well Mr. Clarence Thomas
Producing formation Mississippian Depth to top 4602 Bottom 4616 Total Depth of Well 4662
Show depth and thickness of all water, oil and gas formations.

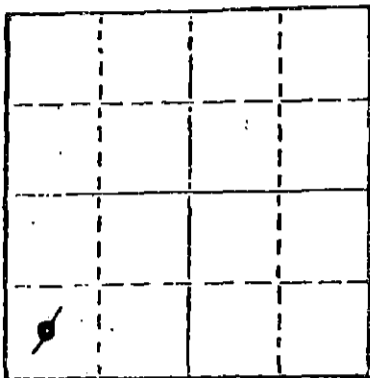

Locate well correctly on above
Section Plot

OIL, GAS OR WATER RECORDS

CASING RECORD

FORMATION	CONTENT	FROM	TO	SIZE	PUT IN	PULLED OUT
Surface		0	502	8 5/8	502	0
Mississippian	Water	0	4,600	4 1/2	4,660	0

Describe in detail the manner in which the well was plugged, indicating where the mud fluid was placed and the method or methods used in introducing it into the hold. If cement or other plugs were used, state the character of same and depth placed, from _____ feet to _____ feet for each plug set.

Mixed 1 sack of hulls and 10 sacks 50/50 pozmix, 2% gel, and released plug.
Displaced with 56 BBL. water to fill casing. Mixed 20 sacks 50/50 pozmix, 2% gel and displaced with 4 BBL. water. Mixed 1 sack cement and shut in.

RECEIVED
STATE CORPORATION COMMISSION

OCT 11 1979

CONSERVATION DIVISION
Wichita, Kansas

10-11-79

(If additional description is necessary, use BACK of this sheet)
Name of Plugging Contractor Sun Oilwell Cementing, Inc.


STATE OF Kansas COUNTY OF Sedgwick, ss.
Janis L. Fox (employee of owner) or (owner or operator)
of the above-described well, being first duly sworn on oath, says: That I have knowledge of the facts, statements, and matters herein contained and the log of the above-described well as filed and that the same are true and correct. So help me God.

(Signature) Janis L. Fox
Suite 670, 7701 E. Kellogg, Wichita, Ks. 67207
(Address)

SUBSCRIBED AND SWORN TO before me this 10th day of October, 1979

Phyllis Gillen
By Phyllis Gillen Notary Public.

My commission expires August 30, 1981

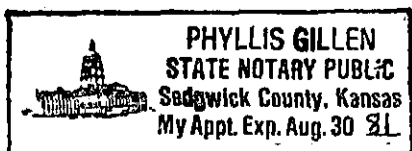

DRILLERS LOG

15-083-20509-0000

No. 1 Bernard Springer

CASING RECORD:	COMPANY:	L. G. Stephenson & Co., Inc.	DESCRIPTION:
8 5/8" @ 502' w/275 sx cmt.	CONTRACTOR:	Red Tiger Drilling Company	C W/2 SW/4 SW/4 Sec. 24-T22S-R24W Hodgeman County, Kansas
4 1/2" @ 4,660' w/125 sx cmt.	COMMENCED:	February 15, 1977	
TOTAL DEPTH: 4,662'	COMPLETED:	March 1, 1977	ELEVATION: 2,404 GL

<u>FORMATION</u>	<u>FROM</u>	<u>TO</u>	<u>REMARKS</u>
Shale	0	240	
Sand	240	290	
Shale	290	510	
Clay & Shale	510	780	
Shale & Red Bed	780	1019	
Anhydrite Blaine	1019	1034	
Shale	1034	1632	
Anhydrite	1632	1675	
Shale	1675	2260	
Shale & Lime	2260	2470	
Lime & Shale	2470	3385	
Sand & Shale	3385	3503	
Lime & Shale	3503	3707	
Sand & Shale	3707	3770	
Lime & Shale	3770	4145	
Lime	4145	4315	
Lime & Shale	4315	4396	
Lime	4396	4662	
RTD		4662	

RECEIVED
STATE CORPORATION COMMISSION
AUG - 9 1979
CONSERVATION DIVISION
Wichita, Kansas

I certify that this is a true and correct copy of the above log to the best of my knowledge.

RED TIGER DRILLING COMPANY

Gloria Fawcett
Gloria Fawcett

Subscribed and sworn to before me this 8th day of March, 1977.

Joyce A. Hagermann
Notary Public

