


STATE OF KANSAS
STATE CORPORATION COMMISSION

Form CP-4

WELL PLUGGING RECORD

Give All Information Completely
Make Required Affidavit
Mail or Deliver Report to:
Conservation Division
State Corporation Commission
212 No. Market
Wichita, Kansas

NORTH

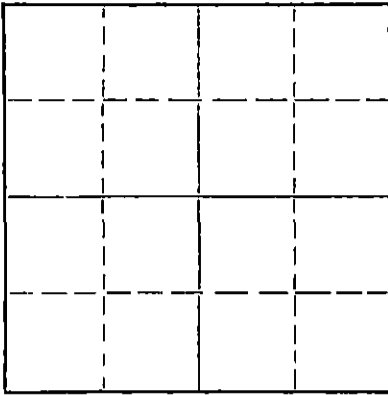

Locate well correctly on above
Section Plat

Hodgeman County, Sec. 24 Twp. 22S Rge. 24W x(E) (W)

Location as "NE/CNW%SW%" or footage from lines 150' So. C SE SE

Lease Owner Leben Drilling, Inc.

Lease Name XXXXXX Springer Well No. A-#1

Office Address Box 486, Great Bend, Kansas 67530

Character of Well (completed as Oil, Gas or Dry Hole) Dry Hole

Date well completed 11-7-67 19

Application for plugging filed 11-7-67 19

Application for plugging approved 11-7-67 19

Plugging commenced 11-7-67 19

Plugging completed: 11-7-67 19

Reason for abandonment of well or producing formation Dry Hole

If a producing well is abandoned, date of last production _____ 19

Was permission obtained from the Conservation Division or its agents before plugging was commenced? yes

Name of Conservation Agent who supervised plugging of this well Edgar Eaves, Sublette

Producing formation _____ Depth to top _____ Bottom _____ Total Depth of Well 4620 Feet

Show depth and thickness of all water, oil and gas formations.

OIL, GAS OR WATER RECORDS

CASING RECORD

FORMATION	CONTENT	FROM	TO	SIZE	PUT IN	PULLED OUT
				8 5/8"	519'	none

Describe in detail the manner in which the well was plugged, indicating where the mud fluid was placed and the method or methods used in introducing it into the hole. If cement or other plugs were used, state the character of same and depth placed, from _____ feet to _____ feet for each plug set.

Filled hole with mud, spotted 100 sks. 50/50 Posmix @ 900'
Spotted 30 sks. 50/50 Posmix @ 450' - bridged @ 40', 10 sks. 50/50 Posmix

RECEIVED
STATE CORPORATION COMMISSION
NOV 14 1967
CONSERVATION DIVISION
Wichita, Kansas

11-13-67

(If additional description is necessary, use BACK of this sheet)

Name of Plugging Contractor Leben Drilling, Inc.

Address Box 486, Great Bend, Kansas 67530

STATE OF KANSAS, COUNTY OF BARTON, ss.

Leslie Kite (employee of owner) or (owner or operator) of the above-described well, being first duly sworn on oath, says: That I have knowledge of the facts, statements, and matters herein contained and the log of the above-described well as filed and that the same are true and correct. So help me God.

(Signature) Leslie Kite

Box 486, Great Bend, Kansas 67530
(Address)

SUBSCRIBED AND SWORN to before me this 9th day of November, 1967

My commission expires April 1, 1971

Ulanda Nichols
Ulanda Nichols
Notary Public.

DRILLER'S LOG

COMPANY: Leben Drilling, Inc. etal
 CONTRACTOR: LEBEN DRILLING, INC.
 FARM: SPRINGER A-#1.
 LOCATION: 150' South C SE SE
 SECTION 24-22S-24W
 HODGEMAN COUNTY, KANSAS
 COMMENCED: 10-27-67
 COMPLETED: 11-7-67

0	40	Clay, Limestone
40	115	Sand, Shale
115	765	Shale, Shells
765	990	Redbed, Shale
990	1025	Anhydrite
1025	1348	Shale, Salt, Sand
1348	1604	Salt, Shale
1604	1640	Anhydrite
1640	2343	Shells & Shale
2343	2585	Shale, Lime
2585	2800	Lime, Shale
2800	2915	Chalky Lime, Shale
2915	3218	Chalky Lime
3218	3385	Chalky Lime, Shale
3385	3530	Chalky Lime
3530	3685	Lime, Shale
3685	3925	Shale, Lime
3925	4179	Lime, Shale
4179	4600	Lime
4600	4620	Lime, Chert
	<u>4620</u>	<u>RTD - D. & A.</u>

RECEIVED
 NOV 28 1967
 COMMISSION DIVISION
 Wichita, Kansas

8 5/8" used 28# surface casing set @ 519' cemented with 300 sacks of Common, 2% cc

I, Leslie Kite, do hereby certify that the above and foregoing is a true and correct copy of the log of the Springer A-#1 Well, located 150' South of C SE SE of Section 24, Township 22 south, Range 24 West, Hodgeman County, Kansas, as reflected by the records of Leben Drilling, Inc.

Leslie Kite
 Leslie Kite

STATE OF KANSAS)
 COUNTY OF BARTON) SS

Subscribed and sworn to and before me, a Notary Public, in and for Barton County, Kansas, this 9th day of November, 1967.

Ulanda Nichols
 Ulanda Nichols

My Commission Expires:
 April 1, 1971