

STATE OF KANSAS
STATE CORPORATION COMMISSION

Form CP-4

WELL PLUGGING RECORD

Give All Information Completely
Make Required Affidavit
Mail or Deliver Report to:
Conservation Division
State Corporation Commission
212 No. Market
Wichita, Kansas

Kingman County. Sec. 25 Twp. 30 Rge. 9 (E) W (W)

Location as "NE/CNW/SW" or footage from lines C N/2 SW SE

Lease Owner ~~SWINGLE~~ Morrison Producing Company

Lease Name Swingle "C" Well No. 1

Office Address El Dorado, Kansas

Character of Well (completed as Oil, Gas or Dry Hole)

Date well completed 19

Application for plugging filed 19

Application for plugging approved 19


Plugging commenced 12-3-66 19

Plugging completed 12-6-66 19

Reason for abandonment of well or producing formation Depleted.

If a producing well is abandoned, date of last production 19

Was permission obtained from the Conservation Division or its agents before plugging was commenced? Yes

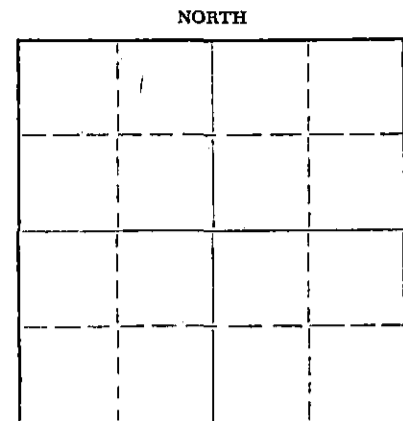

Locate well correctly on above Section Plat

Name of Conservation Agent who supervised plugging of this well Archie Elving

Producing formation Depth to top Bottom Total Depth of Well 3222 Feet

Show depth and thickness of all water, oil and gas formations.

OIL, GAS OR WATER RECORDS

CASING RECORD

FORMATION	CONTENT	FROM	TO	SIZE	PUT IN	PULLED OUT
				8-5/8"	409'	None
				4-1/2"	3215'	1840'

Describe in detail the manner in which the well was plugged, indicating where the mud fluid was placed and the method or methods used in introducing it into the hole. If cement or other plugs were used, state the character of same and depth placed, from feet to feet for each plug set.

Checked hole, sanded hole to 2425' and dumped 3 sacks of cement @ 2425' with dump bailer. Pulled 4 1/2" casing, set rock bridge @ 370' and dumped 25 sacks of cement. Mudded hole to 40', set rock bridge and ran 10 sacks of cement to cap well.

12-13-66

RECEIVED
STATE CORPORATION COMMISSION
DEC 13 1966
CONSERVATION DIVISION
Wichita, Kansas

PLUGGING COMPLETE.

Name of Plugging Contractor KNIGHT CASING PULLING COMPANY
Address CHASE, KANSAS

STATE OF KANSAS COUNTY OF RICE, ss. Noel J. Knight (employee of owner) or (owner or operator) of the above-described well, being first duly sworn on oath, says: That I have knowledge of the facts, statements, and matters herein contained and the log of the above-described well as filed and that the same are true and correct. So help me God.

(Signature) Noel J. Knight
Chase, Kansas
(Address)

SUBSCRIBED AND SWORN TO before me this 7th day of December, 19 66

My commission expires May 20, 1968 Notary Public.