

STATE OF KANSAS  
STATE CORPORATION COMMISSION

WELL PLUGGING RECORD

Give All Information Completely  
Make Required Affidavit  
Mail or Deliver Report to  
Conservation Division  
State Corporation Comm.  
245 North Water  
Wichita, KS 67202

Kingman County, Sec. 25 Twp. 30 Rge. 9 NW  
Location as "NE/CNW $\frac{1}{4}$ SW $\frac{1}{4}$ " or footage from lines  
C NW NW

Lease Owner White & Ellis Drilling, Inc.  
Lease Name Deppenbusch Well No. 1  
Office Address 401 E. Douglas Suite 500 Wichita, Ks.

Character of Well (Completed as Oil, Gas or Dry Hole)  
Dry Hole

Date Well completed 5/1/80  
Application for plugging filed 5/1/80  
Application for plugging approved 5/1/80  
Plugging commenced 5/1/80  
Plugging completed 5/1/80

Reason for abandonment of well or producing formation  
Dry Hole


If a producing well is abandoned, date of last production

Was permission obtained from the Conservation Division  
its agents before plugging was commenced? Yes

Name of Conservation Agent who supervised plugging of this well Wm. T. Owen

Producing formation Depth to top Bottom Total Depth of Well

Show depth and thickness of all water, oil and gas formations.

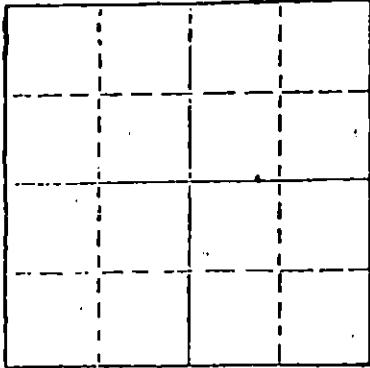

Locate well correctly on above Section Plot

OIL, GAS OR WATER RECORDS

CASING RECORDS

FORMATION	CONTENT	FROM	TO	SIZE	PUT IN	PULLED OUT
				8 5/8"	264'	


Describe in detail the manner in which the well was plugged, indicating where the mud was placed and the method or methods used in introducing it into the hold. If cement or other plugs were used, state the character of same and depth placed, from feet to feet for each plug set.

5/1/80 Mud to 300', plug, plugged with 50 sx cement.

5/1/80 Mud to 40', plug, plugged with 10 sx cement.

5/1/80 Plugged rathole with 5 sx cement.

5-14-80

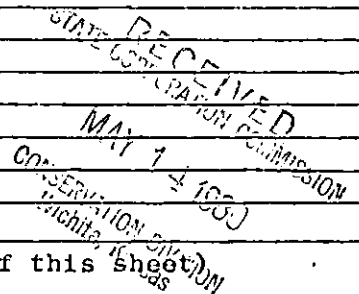

(If additional description is necessary, use BACK of this sheet)

Name of Plugging Contractor White & Ellis Drilling, Inc.  
Box 448, El Dorado, Ks. 67042


STATE OF Kansas COUNTY OF Butler, ss.  
Ernest Sifford (employee of owner) or (owner or operator)  
of the above-described well, being first duly sworn on oath, says: That I have knowledge of the facts, statements, and matters herein contained and the log of the above-described well as filed and that the same are true and correct. So help me God.

(Signature) Ernest Sifford  
El Dorado  
(Address)

SUBSCRIBED AND SWORN TO before me this 7 day of May, 1980

Florence C. Tallafiero  
Notary Public.

My commission expires

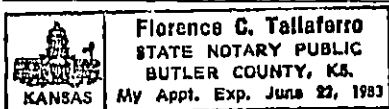

### DRILLERS LOG

OPERATOR: White & Ellis Drlg, Inc.; 401 E. Douglas; Suite 500; Wichita, Ks.  
CONTRACTOR: White & Ellis Drilling, Inc., Box 448, El Dorado, Kansas 67042 67202

Lease Name Deppenbusch Well No. 1  
Sec. 25 T. 30 R. 9W Spot C NW NW  
County Kingman State Kansas Elevation \_\_\_\_\_

**Casing Record:**

Surface: 8 5/8" @ 264' with 185 Sxs.

Production: \_\_\_\_\_ @ \_\_\_\_\_ with \_\_\_\_\_ Sxs.

Type Well: D & A Total Depth 4270' KB

Drilling Commenced: 4/18/80 Drilling Completed 5/1/80

Formation	From	To	Tops
Cellar	0	7	
Shale, Sand	7	1745	
Shale, Lime	1745	4259	
Lime	4259	4270	

### COMPLETION RECORD

Liner Record: Size \_\_\_\_\_ From \_\_\_\_\_ To \_\_\_\_\_

Cementing Record: \_\_\_\_\_ Sacks \_\_\_\_\_

**Perforating Record:**

Formation	Perforated Interval	Number Shots

Initial Production: \_\_\_\_\_

Electric Log \_\_\_\_\_  
Type and Depths Covered \_\_\_\_\_  
\_\_\_\_\_

RECEIVED  
STATE CORPORATION COMMISSION  
MAY 14 1980  
COMPLETION DIVISION  
Wichita, Kansas