


STATE OF KANSAS
STATE CORPORATION COMMISSION

WELL PLUGGING RECORD

Give All Information Completely
Make Required Affidavit
Mail or Deliver Report to
Conservation Division
State Corporation Comm.
245 North Water
Wichita, KS 67202

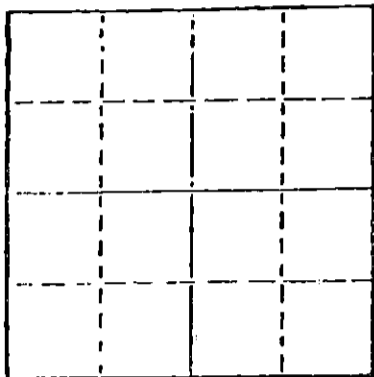

Locate well correctly on above
Section Plot

Kingman County, Sec. 33 Twp. 30S Rge. 9W 18/W
Location as "NE/CNW $\frac{1}{4}$ SW $\frac{1}{4}$ " or footage from lines
NW/4 NW/4 NW/4

Lease Owner Gear Petroleum Company
Lease Name Nichols Well No. 1
Office Address 1325 Vickers/KSB&T Bldg., Wichita, Ks. 67202
Character of Well (Completed as Oil, Gas or Dry Hole) _____
D & A

Date Well completed May 3, 1978
Application for plugging filed May 4, 1978
Application for plugging approved May 4, 1978
Plugging commenced May 4, 1978
Plugging completed May 4, 1978

Reason for abandonment of well or producing formation _____
D & A

If a producing well is abandoned, date of last production _____
19

Was permission obtained from the Conservation Division or
its agents before plugging was commenced? Yes

Name of Conservation Agent who supervised plugging of this well Jasper H. Metz
Producing formation _____ Depth to top _____ Bottom _____ Total Depth of Well 4,358'
Show depth and thickness of all water, oil and gas formations.

OIL, GAS OR WATER RECORDS

CASING RECORD

FORMATION	CONTENT	FROM	TO	SIZE	PUT IN	PULLED OUT
				8 5/8"	202.50'	-0-

Describe in detail the manner in which the well was plugged, indicating where the mud fluid was placed and the method or methods used in introducing it into the hold. If cement or other plugs were used, state the character of same and depth placed, from _____ feet to _____ feet for each plug set.

Mud to 210' w/35 sx cement
Mud to 40', 1/2 sx hulls, plug & 12 sx cement
3 sx cement in rathole
(50-50 Pozmix)

RECEIVED
STATE CORPORATION COMMISSION

MAY 10 1978

5-10-78

CONSERVATION DIVISION
Wichita, Kansas

(If additional description is necessary, use BACK of this sheet)

Name of Plugging Contractor Red Tiger Drilling Company
1720 KSB&T Building, Wichita, Kansas 67202

STATE OF Kansas COUNTY OF Sedgwick, ss. contractor
Gloria Fawcett (employee of ~~owner~~)


of the above-described well, being first duly sworn on oath, says: That I have knowledge of the facts, statements, and matters herein contained and the log of the above-described well as filed and that the same are true and correct. So help me God.

(Signature) Gloria Fawcett
1720 KSB&T Building, Wichita, Kansas 67202
(Address)

SUBSCRIBED AND SWORN TO before me this 8th day of May, 1978.

My commission expires _____

Joyce A. Hagermann
Notary Public.

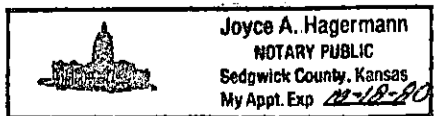

DRILLERS LOG

No. 1 Nichols

CASING RECORD:

COMPANY: Gear Petroleum Company

DESCRIPTION:

8 5/8" @ 209.10'
w/200 sx cement

CONTRACTOR: Red Tiger Drilling Company

NW/4 NW/4 NW/4
Sec. 33-T30S-R9W
Kingman County, Kansas

COMMENCED: April 24, 1978

COMPLETED: May 4, 1978

TOTAL DEPTH: 4,358'

ELEVATION: 1,622' KB

<u>FORMATION</u>	<u>FROM</u>	<u>TO</u>	<u>REMARKS</u>
Surface Soil & Shale	0	30	
Red Bed	30	524	
Red Bed & Shale	524	1380	
Lime	1380	1390	
Shale	1390	1480	
Lime	1480	1811	
Lime & Shale	1811	2500	
Lime	2500	2557	
Shale w/Sand Streaks	2557	2573	
Shale w/Lime	2573	2651	
Sand	2651	2690	
Lime	2690	3530	
Shale & Lime	3530	3622	
Lime	3622	4315	
Mississippi	4315	4328	
Lime	4328	4358	
RTD		4358	

I certify that this is a true and correct copy of the above log to the best of my knowledge.

RECEIVED
STATE CORPORATION COMMISSION

RED TIGER DRILLING COMPANY

MAY 10 1978

CONSERVATION DIVISION
Wichita, Kansas

Gloria Fawcett
Gloria Fawcett

Subscribed and sworn to before me this 8th day of May, 1978.

Joyce A. Hagermann

