


STATE OF KANSAS
STATE CORPORATION COMMISSION

WELL PLUGGING RECORD

Give All Information Completely
Make Required Affidavit
Mail or Deliver Report to:
Conservation Division
State Corporation Commission
212 No. Market
Wichita, Kansas

Kingman County, Sec. 33 Twp. 30S Rge. ~~28~~9 (W)
Location as "NE/CNW/SW" or footage from lines ~~C NW NW~~ NW NE SE
Lease Owner Vincent Oil Corporation
Lease Name Twyman Well No. 1
Office Address 719 Union Center, Wichita, Kansas 67202
Character of Well (completed as Oil, Gas or Dry Hole) Dry Hole
Date well completed June 18, 19 74
Application for plugging filed June 18, 19 74
Application for plugging approved June 18, 19 74
Plugging commenced June 18, 19 74
Plugging completed June 18, 19 74
Reason for abandonment of well or producing formation Dry Hole

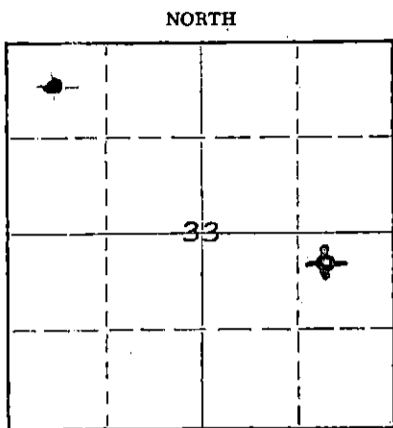

Locate well correctly on above Section Flat

If a producing well is abandoned, date of last production _____ 19____
Was permission obtained from the Conservation Division or its agents before plugging was commenced? _____

Name of Conservation Agent who supervised plugging of this well _____
Producing formation _____ Depth to top _____ Bottom _____ Total Depth of Well 4415 Feet
Show depth and thickness of all water, oil and gas formations.

OIL, GAS OR WATER RECORDS

CASING RECORD

FORMATION	CONTENT	FROM	TO	SIZE	PUT IN	PULLED OUT
		0	253'	8-5/8"	253'	None

Describe in detail the manner in which the well was plugged, indicating where the mud fluid was placed and the method or methods used in introducing it into the hole. If cement or other plugs were used, state the character of same and depth placed, from _____ feet to _____ feet for each plug set.

Hole filled with mud & hulls 4415-200'
Plug 200-196'
25 sacks cement 196'-40'
Plug 40'-36'
10 sacks cement 36'-6'
2 sacks cement in rat hole.

RECEIVED
STATE CORPORATION COMMISSION
JUL 9 1974
CONSERVATION DIVISION
Wichita, Kansas

RECEIVED
STATE CORPORATION COMMISSION
JUL 2 1974
CONSERVATION DIVISION
Wichita, Kansas

(If additional description is necessary, use BACK of this sheet)
Name of Plugging Contractor Halliburton Services
Address Pratt, Kansas

STATE OF KANSAS, COUNTY OF SEDGWICK, ss:
John D. Knightley (Agent) ~~(employee of owner)~~ ~~(owner or operator)~~ of the above-described well, being first duly sworn on oath, says: That I have knowledge of the facts, statements, and matters herein contained and the log of the above-described well as filed and that the same are true and correct. So help me God.

(Signature) *[Signature]*
301 S. Broadway, Wichita, Kansas 67202
(Address)

SUBSCRIBED AND SWORN TO before me this 1st day of July, 19 74

[Signature]
Notary Public.

My commission expires March 12, 1975

Vincent Oil Corporation - Twyman #1
 NW NE SE Sec. 33-30S-9W
 Kingman County, Kansas

Contractor: D. R. Lauck Oil Company, Inc.
 301 S. Broadway
 Wichita, Kansas 67202

RECEIVED
 STATE CORPORATION COMMISSION

JUL 2 1974

Commenced: June 10, 1974
 Completed: June 18, 1974

CONSERVATION DIVISION
 Wichita, Kansas

Drillers Log

Clay & Sand	65
Sand	85
Shale	185
Red Bed	253
Shale & Shells	1440
Shale w/Lime Streaks	1625
Shale & Lime	1842
Lime & Shale	2490
Shale & Lime	2740
Lime & Shale	3805
Lime	4415 RTD