

STATE OF KANSAS
STATE CORPORATION COMMISSION

Form CP-4

WELL PLUGGING RECORD

Give All Information Completely
Make Required Affidavit
Mail or Deliver Report to:
Conservation Division
State Corporation Commission
212 No. Market
Wichita, Kansas

KINGMAN County, Sec. 33 Twp. 30s Rge. 9 (E) (W)

Location as "NE/CNW/SW" or footage from lines SW NW NE

Lease Owner PETROLEUM, INC.

Lease Name CASEBOLT Well No. 1

Office Address R.R. #2, GREAT BEND, KANSAS

Character of Well (completed as Oil, Gas or Dry Hole) DRY HOLE

Date well completed FEBRUARY 28 1967

Application for plugging filed FEBRUARY 28 1967

Application for plugging approved FEBRUARY 28 1967


Plugging commenced FEBRUARY 28 1967

Plugging completed FEBRUARY 28 1967

Reason for abandonment of well or producing formation NO PRODUCIBLE ZONE

If a producing well is abandoned, date of last production NONE 19

Was permission obtained from the Conservation Division or its agents before plugging was commenced? YES

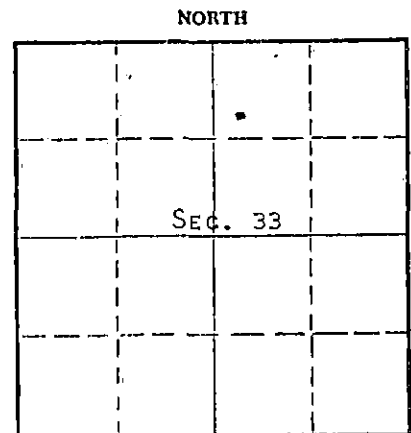

Locate well correctly on above Section Plat

Name of Conservation Agent who supervised plugging of this well ARCHIE ELVING

Producing formation Depth to top Bottom Total Depth of Well 4407 Feet

Show depth and thickness of all water, oil and gas formations.

OIL, GAS OR WATER RECORDS

CASING RECORD

FORMATION	CONTENT	FROM	TO	SIZE	PUT IN	PULLED OUT
				8-5/8"	249'	NONE

Describe in detail the manner in which the well was plugged, indicating where the mud fluid was placed and the method or methods used in introducing it into the hole. If cement or other plugs were used, state the character of same and depth placed, from feet to feet for each plug set.

MUD TO 240', FOLLOWED BY WOODEN PLUG, PLACED 1/2 SACK HULLS, 1 SACK DRY CEMENT BRIDGE TO HOLD PIPE, 25 SACKS CEMENT. MUD TO 40', FOLLOWED BY WOODEN PLUG, BRIDGED W/1/2 SACK HULLS, 1 SACK DRY CEMENT, 10 SACKS CEMENT TO BASE OF WELL CELLAR.

RECEIVED
STATE CORPORATION COMMISSION
MAR 13 1967
3-13-67
CONSERVATION DIVISION
Wichita, Kansas

(If additional description is necessary, use BACK of this sheet)

Name of Plugging Contractor GARVEY DRILLING COMPANY

Address R.R. #2, GREAT BEND, KANSAS

STATE OF KANSAS, COUNTY OF BARTON, ss.

MONTE CHADD (employee of owner) or (owner or operator) of the above-described

well, being first duly sworn on oath, says: That I have knowledge of the facts, statements, and matters herein contained and the log of the above-described well as filed and that the same are true and correct. So help me God. MONTE CHADD, DIST. PROD. SUPT.

(Signature)

R.R. #2, GREAT BEND, KANSAS (Address)

Subscribed and Sworn to before me this 10 day of MARCH, 1967

Richard H. D... Notary Public.

WELL LOG

COMPANY Petroleum, Inc.

SEC. 33 T.30S R. 9W

FARM Casebolt NO. 1


LOC. SW NW NE

TOTAL DEPTH 4407'

COUNTY Kingman

COMM. 2-16-67 COMP. 2-27-67

CONTRACTOR Garvey Drilling Company

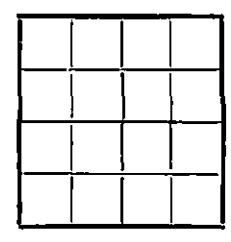

CASING 8 5/8" @ 249' w/200 SX

ELEVATION 1611' DF

PRODUCTION D & A

FIGURES INDICATE BOTTOM OF FORMATIONS

- 30' Surface Clay and Sand
- 70' Sand
- 1155' Red Bed
- 1425' Shale
- 1520' Lime
- 1972' Lime and Shale
- 2090' Shale and Lime
- 2410' Lime and Shale
- 2905' Shale and Lime
- 3063' Lime and Shale
- 3340' Shale and Lime
- 3720' Lime and Shale
- 4100' Lime
- 4245' Lime and Shale
- 4312' Shale
- 4369' Mississippi Chert
- 4407' Lime
- 4407' RTD

RECEIVED
 STATE CORPORATION COMMISSION
 MAR 13 1967
 CONSERVATION DIVISION
 Wichita, Kansas

State of Kansas
 County of Barton } ss

I, Sam N. Stephens of Garvey Drilling Company

upon oath state the above and foregoing is a true and correct copy of the log of the Casebolt No. 1 well.

Sam N. Stephens

Subscribed and sworn to before me this 7th day of March 19 67

My Commission Expires: November 5th, 1969

Richard A. Boyd

 NOTARY PUBLIC