


STATE OF KANSAS
STATE CORPORATION COMMISSION

Give All Information Completely
Make Required Affidavit
Mail or Deliver Report to:
Conservation Division
State Corporation Commission
211 No. Broadway
Wichita, Kansas

WELL PLUGGING RECORD

NORTH

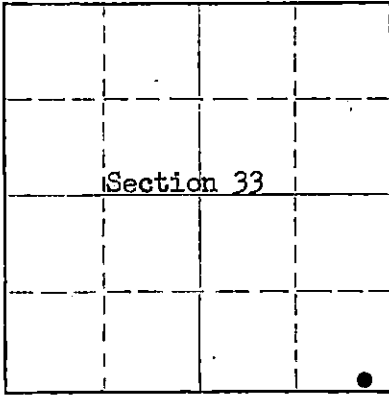

Locate well correctly on above
Section Plat

Kingman County. Sec. 33 Twp. 30 Rge. 9 (E) W (W)
Location as "NE/CNW&SW&" or footage from lines SE SE SE
Lease Owner Petroleum, Inc.
Lease Name Twyman Well No. 1
Office Address Route 2, Great Bend, Kansas
Character of Well (completed as Oil, Gas or Dry Hole) Dry hole
Date well completed July 8 19 58
Application for plugging filed July 8 19 58
Application for plugging approved July 8 19 58
Plugging commenced July 8 19 58
Plugging completed July 8 19 58
Reason for abandonment of well or producing formation No producible zones

If a producing well is abandoned, date of last production None 19
Was permission obtained from the Conservation Division or its agents before plugging was commenced? Yes

Name of Conservation Agent who supervised plugging of this well Fred Hampel
Producing formation _____ Depth to top. _____ Bottom _____ Total Depth of Well 4536 Feet
Show depth and thickness of all water, oil and gas formations.

OIL, GAS OR WATER RECORDS

CASING RECORD

FORMATION	CONTENT	FROM	TO	SIZE	PUT IN	PULLED OUT
				8 5/8"	279'	None

Describe in detail the manner in which the well was plugged, indicating where the mud fluid was placed and the method or methods used in introducing it into the hole. If cement or other plugs were used, state the character of same and depth placed, from _____ feet to _____ feet for each plug set.

Mud up with heavy mud to 265' followed by a wooden plug and 1/3 sack hulls. Placed 20 sacks cement on to plug through drill pipe. Mud up to 40' followed by a wooden plug and 1/3 sack hulls. Filled hole to base of well cellar with 10 sacks cement.

(If additional description is necessary, use BACK of this sheet)

Name of Plugging Contractor Gargey Drilling Co.
Address Route 2, Great Bend, Kansas

STATE OF Kansas COUNTY OF Barton, ss.
Ray Zimmerman (employee of owner) or (owner or operator) of the above-described well, being first duly sworn on oath, says: That I have knowledge of the facts, statements, and matters herein contained and the log of the above-described well as filed and that the same are true and correct. So help me God.

(Signature) Ray Zimmerman
Route 2, Great Bend, Kansas
(Address)

SUBSCRIBED AND SWORN TO before me this 11th day of July 19 58
Del. T. Bissler
Notary Public.

My commission expires July 11, 1960

PLUGGING
FILE SEC. 33 T. 30 R. 9W
BOOK PAGE 114 LINE 35

WELL LOG

COMPANY PETROLEUM, INCORPORATED

SEC. 33 T. 30S R. 9W

FARM TWYMAN NO. 1


LOC. SE, SE, SE

TOTAL DEPTH 4536'

COUNTY KINGMAN CO., KANSAS

COMM. June 26, 1958 COMP. July 8, 1958

CONTRACTOR GARVEY DRILLING COMPANY

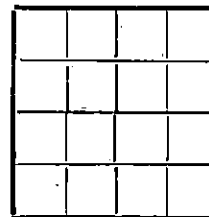

CASING 8 5/8" @ 279' W/200 sax.

ELEVATION 1710' DF

PRODUCTION D & A

FIGURES INDICATE BOTTOM OF FORMATIONS

75	Sand
200	Red bed
660	Red bed & shale
1650	Shale & shells
1770	Shale & lime
2075	Lime
2370	Shale & lime
2525	Lime & shale
2710	Shale & lime
2815	Shale
2940	Lime & shale
3115	Shale & broken lime
3245	Shale & lime
3540	Lime & shale
3697	Shale & sand
3841	Lime & shale
4252	Lime
4290	Shale & lime
4393	Lime & shale
4469	Lime
4524 k	Lime & shale
4536	Lime
4536	T. D.

RECEIVED
STATE CORPORATION COMMISSION

JUL 12 1958

CONSERVATION DIVISION
Wichita, Kansas

PLUGGING	
FILE	SEC. 33 T. 30 R. 9W
BOOK	PAGE 114 LINE 35

State of KANSAS }
County of BARTON } ss:

I, VERNE A. MORRIS of GARVEY DRILLING CO.

upon oath state that the above and foregoing is a true and correct copy of the log of the #1 TWYMAN well

Subscribed and sworn to before me this 10th day of July 19 58
Verne A. Morris

My Commission Expires: July 11, 1960

John T. Brown
NOTARY PUBLIC