


WELL PLUGGING RECORD

All Information Completely
Required Affidavit
or Deliver Report to:
Conservation Division
State Corporation Commission
211 No. Broadway
Wichita, Kansas

NORTH

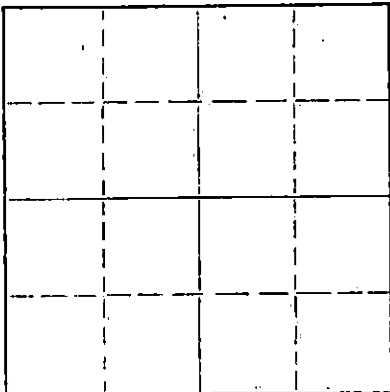

Locate well correctly on above
Section Plat

Kingman County. Sec. 33 Twp. 30S Rge. 9W (E) (W)
Location as "NE/CNW/SW" or footage from lines SW SE NW
Lease Owner Pickrell Drilling Company
Lease Name Scarth Well No. 1
Office Address North Main Great Bend, Kansas
Character of Well (completed as Oil, Gas or Dry Hole) Oil
Date well completed 19____
Application for plugging filed 19____
Application for plugging approved 19____
Plugging commenced April 24, 1963 19____
Plugging completed April 26, 1963 19____
Reason for abandonment of well or producing formation Dry

If a producing well is abandoned, date of last production 19____
Was permission obtained from the Conservation Division or its agents before plugging was commenced? Yes

Name of Conservation Agent who supervised plugging of this well Archie Elving
Producing formation _____ Depth to top _____ Bottom _____ Total Depth of Well PB 4398 Feet
Show depth and thickness of all water, oil and gas formations.

OIL, GAS OR WATER RECORDS

CASING RECORD

FORMATION	CONTENT	FROM	TO	SIZE	PUT IN	PULLED OUT
				8 5/8	232	none
				5 1/2	none	383 1/2

Describe in detail the manner in which the well was plugged, indicating where the mud fluid was placed and the method or methods used in introducing it into the hole. If cement or other plugs were used, state the character of same and depth placed, from _____ feet to _____ feet for each plug set.

Moved on, cleaned out cellar and sanded to 4340'. Dumped 3 sx. cement and worked pipe.

Worked pipe and shot @ 3900'-3815'. Started pulling pipe.

Finished pulling pipe and plugged well with mud @ 180'. Built 10 ft. rock bridge and dumped 20 sx. cement. Filled hole and rock bridge and capped well with 10 sx. cement.

RECEIVED
STATE CORPORATION COMMISSION

MAY 6 1963

CONSERVATION DIVISION
Wichita, Kansas

(If additional description is necessary, use BACK of this sheet)

Name of Plugging Contractor Forbes Casing Pulling, Inc.
Address Box 221 Great Bend, Kansas

STATE OF Kansas, COUNTY OF Barton, ss.
J. O. Forbes (employee of owner) or (owner or operator) of the above-described

well, being first duly sworn on oath, says: That I have knowledge of the facts, statements, and matters herein contained and the log of the above-described well as filed and that the same are true and correct. So help me God.

(Signature) J. O. Forbes
Box 221 Great Bend, Kansas
(Address)

SUBSCRIBED AND SWORN TO before me this 29th day of April, 1963

Carolyn Haven
Notary Public.

My commission expires July 23, 1966

ROTARY DRILLING LOG

COMPANY: **PICKRELL DRILLING COMPANY**
705 4th National Bank Bldg
Wichita, Kansas
LOCATION: Search No. 1, SW SE 1/4 33-32-9,
Kingman County, Kansas

Rotary Drilling Commenced 3-22-63

Rotary Drilling Completed 4-2-63

CONTRACTOR: **PICKRELL DRILLING COMPANY**
Wichita, Kansas

CASING RECORD: (6 jtc) 232' 8 5/8" Surface Casing set with 185 sacks cement.
Circulated. (144) jtc) 4 1/2" Casing set at 4429' with 215 sacks
cement. Completed 5:30 A.M. April 3, 1963.

LOG

(Figures indicate bottom of formation — measurements from top of rotary bushing.)

65	Sand	<u>C. F. S.</u>
233	Red Rock	4360
720	Red rock & Shale	4375
1495	Shale & Shells	4385
1635	Limo & Shale	4400
2160	Limo	4429
3781	Limo & Shale	
4191	Limo	<u>Slope Test</u>
4375	Limo, Shale & Mississippian	1530
4429	RED	2500
		3500
		4000
		<u>S. I. II.</u>
		2421
		3266
		4035

RECEIVED
STATE CORPORATION COMMISSION

MAY 6 1963

CONSERVATION DIVISION
Wichita, Kansas

The undersigned, C. U. Seditz, Attorney-in-Fact for PICKRELL DRILLING COMPANY, hereby certifies in behalf of said Company, that the above is a true and correct log of the formation encountered in drilling the above well as reflected by the Daily Drilling Reports.

PICKRELL DRILLING COMPANY

By C. U. Seditz
Attorney-in-Fact

STATE OF KANSAS }
COUNTY OF SEDGWICK } SS.

On this 5th day of April, 1963, before me the undersigned, a Notary Public, in and for the County and State aforesaid, personally appeared C. U. Seditz, to me known to be the identical person who subscribed the name of PICKRELL DRILLING COMPANY to the foregoing instrument as its Attorney-in-Fact and acknowledged to me that he executed the same as his free and voluntary act and deed, and as the free and voluntary act and deed of such company, for the uses and purposes therein set forth.

Given under my hand and seal of office the day and year last above written.

Marion Blackman
Notary Public

My commission expires: June 22, 1965

Marion Blackman