


WELL PLUGGING RECORD

Give All Information Completely
Make Required Affidavit
Mail or Deliver Report to:
Conservation Division
State Corporation Commission
211 No. Broadway
Wichita, Kansas

NORTH

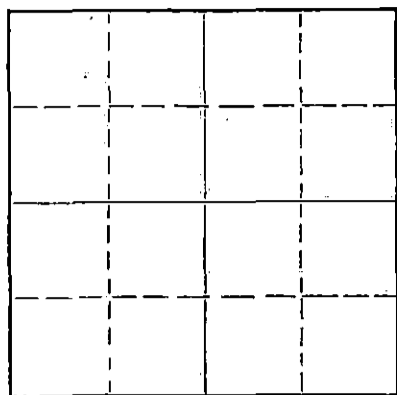

Locate well correctly on above
Section Plat

Kingman County, Sec. 34 Twp. 30 Rge. 9 (W)
Location as "NE/CNW/SW" or footage from lines SW - SW - NW
Lease Owner Great Bend Pipe & Supply
Lease Name Swingle Well No. 1
Office Address Great Bend, Kansas
Character of Well (completed as Oil, Gas or Dry Hole)
Date well completed 19
Application for plugging filed 19
Application for plugging approved 19
Plugging commenced 6-13 1957
Plugging completed 6-19 1957
Reason for abandonment of well or producing formation

If a producing well is abandoned, date of last production 19
Was permission obtained from the Conservation Division or its agents before plugging was commenced? yes

Name of Conservation Agent who supervised plugging of this well M. A. River
Producing formation Depth to top Bottom Total Depth of Well Feet
Show depth and thickness of all water, oil and gas formations.

OIL, GAS OR WATER RECORDS

CASING RECORD

FORMATION	CONTENT	FROM	TO	SIZE	PUT IN	PULLED OUT
				8 5/8	360	None
				5 1/2	4439	3821.35

Describe in detail the manner in which the well was plugged, indicating where the mud fluid was placed and the method or methods used in introducing it into the hole. If cement or other plugs were used, state the character of same and depth placed, from feet to feet for each plug set.

Sanded to 4358 - ran 5 sks cement - pulled pipe - called pump trucks - pumped in 20 sks mud and 75 sks cement - checked top of cement next day - cement to top of surface pipe.

RECEIVED
STATE CORPORATION COMMISSION

JUL 2 - 1957 7-2-57

CONSERVATION DIVISION
Wichita, Kansas

(If additional description is necessary, use BACK of this sheet)

Name of Plugging Contractor R & D Casing Pulling Company License # 236
Address Box 569 Ellinwood, Kansas

STATE OF Kansas, COUNTY OF Barton ss.
Nathan Meltzer (employee of owner) or (owner or operator) of the above-described well, being first duly sworn on oath, says: That I have knowledge of the facts, statements, and matters herein contained and the log of the above-described well as filed and that the same are true and correct. So help me God.

(Signature) Nathan Meltzer
Great Bend, Kansas (Address)

SUBSCRIBED AND SWORN TO before me this First day of July 19 57

My commission expires 3/30/61

Notary Public.

PLUGGING
FILE SEC. 34 T. 30 R. 9W
BOOK PAGE 22 LINE 4

WELL LOG BUREAU—KANSAS GEOLOGICAL SOCIETY
508 East Murdock, Wichita, Kansas


15-095-01315-0000
COPY

Company. ARTNELL COMPANY
Farm. Swingle No. 1

SEC. 34 T. 30 R. 9W
SW SW NW

Total Depth. 4440
Comm. 12-19-56 Comp. 1-5-57
Shot or Treated.
Contractor. Prime Drilling Co.
Issued. 6-22-57

County Kingman
KANSAS

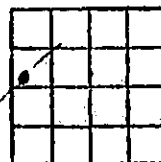

Elevation. 1681 KB

Production. Dry

CASING:

8 5/8 @ 236' w/ 200 sx cmt.
5 1/2 @ 4438' w/ 100 sx cmt.

Figures Indicate Bottom of Formations.

sand & shale	65
sand	95
shale, shells & red bed	130
red bed & shells	300
shale, shells & red bed	700
gray shale & shells	1205
shale & anhydrite streaks	1240
shale & shells	1440
anhydrite	1550
lime & shale	1595
lime	2070
lime & shale	3005
lime	3055
lime & shale	3260
lime	3405
shale & lime	3495
lime	3602
shale & sand	3673
lime	3695
lime & shale	3745
lime	4225
lime & shale streaks	4260
lime & shale	4320
lime	4365
lime & shale	4374
lime	4390
Mississippi chert	4405
lime 300,000 CFGP/D	4440
Total Depth	

Tops: Schlumberger

Heebner	3466
Douglas	3502
Lansing	3673
Base Kansas City	4186
Marmaton	4198
Mississippian	4371

Schlumberger Total Depth 4439

RECEIVED
STATE CORPORATION COMMISSION

DEC 6 1957
CONSERVATION DIVISION
Wichita, Kansas

PLUGGING
FILE SEC. 34 T. 30 R. 9W
BOOK PAGE 22 LINE 4