


STATE OF KANSAS
STATE CORPORATION COMMISSION

WELL PLUGGING RECORD

Give All Information Completely
Make Required Affidavit
Mail or Deliver Report to:
Conservation Division
State Corporation Commission
211 No. Broadway
Wichita, Kansas

Kingman County, Sec. 3 Twp. 30 Rge. 10 (E) (W)

Location as "NE/CNW/SW" or footage from lines NE NE SW
Lease Owner Welch & Olsson Drilling Company, Inc.
Lease Name Liebl Well No. 1
Office Address 203 Rule Bldg. Wichita, Kansas.

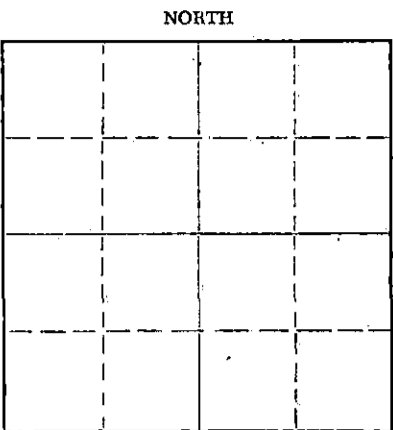

Locate well correctly on above
Section Plat

Character of Well (completed as Oil, Gas or Dry Hole) D & A
Date well completed 11-3 19 56
Application for plugging filed 11-3 19 56
Application for plugging approved 11-3 19 56
Plugging commenced 11-3 19 56
Plugging completed 11-3 19 56
Reason for abandonment of well or producing formation D & A

If a producing well is abandoned, date of last production none 19
Was permission obtained from the Conservation Division or its agents before plugging was commenced? yes

Name of Conservation Agent who supervised plugging of this well M. A. Rives, Box 8, Pratt, Kansas.
Producing formation Depth to top Bottom Total Depth of Well 4685 Feet
Show depth and thickness of all water, oil and gas formations.

OIL, GAS OR WATER RECORDS

CASING RECORD

FORMATION	CONTENT	FROM	TO	SIZE	PUT IN	PULLED OUT
				8 5/8	258'	None

Describe in detail the manner in which the well was plugged, indicating where the mud fluid was placed and the method or methods used in introducing it into the hole. If cement or other plugs were used, state the character of same and depth placed, from feet to feet for each plug set.

Mudded to 250'. Set plug. Added 1/2 sack of hulls and
cemented with 20 sacks of cement. Mudded to 30'. added 1/2
sack of hulls, Set plug and cemented with 10 sacks of cement.

RECEIVED
STATE CORPORATION COMMISSION
NOV-7-1956
CONSERVATION DIVISION
Wichita, Kansas

11-7-56

Name of Plugging Contractor Welch & Olsson Drilling Company, Inc.
Address 203 Rule Bldg. Wichita, Kansas.

STATE OF Kansas, COUNTY OF Sedgwick, ss.
R.E. Welch (owner or operator) of the above-described well, being first duly sworn on oath, says: That I have knowledge of the facts, statements, and matters herein contained and the log of the above-described well as filed and that the same are true and correct. So help me God.
(Signature) [Signature]
203 Rule Bldg. Wichita, Kansas. (Address)

SUBSCRIBED AND SWORN TO before me this 5th day of November, 19 56

My commission expires June 12, 1959
Edith Erker Notary Public.

PLUGGING
FILE SEC. 3 T. 30 R. 10W
BOOK PAGE 113 LINE 10

Welch & Olsson Drilling Company, Inc. ELEVATION: 1698 R.B.
 Contractor: Welch & Olsson Drilling Company, Inc. Comm. Drlg: 10-18-56
 LIEBL #1 NE NE SW of Sec. 3-30-10W, Kingman County, Kansas. Compl. Drlg: 11-3-56
 Production: D & A

Casing Record.

Set 258' of 8 5/8" with 200 sacks of cement.

(Figures indicate bottom of formations.)

<u>FORMATIONS</u>	<u>DEPTHS</u>	<u>FORMATION TOPS.</u>
Sand:	85	Heebner: 3529 (1831)
Red Bed:	450	Douglas: 3598 (-1900)
Red Bed & Shale:	650	Brown Lime: 3705 (-2007)
Shale:	1312	Lansing-Kansas City: 3719 (-2021)
Anhydrite:	1325	Mississippi: 4290 (-2592)
Shale & Shells:	1460	Kinderhook Shale: 4388 (-2690)
Lime & Shells:	1640	Viola: 4587 (-2889)
Lime & Shale:	1925	Simpson: 4660 (-2962)
Lime:	1995	
Shale & Shells:	2050	
Shale & Lime:	2175	
Shale W/lime Strs:	2310	
Shale & Lime:	2600	
Shale & Shells:	2825	
Shale & Lime:	2940	
Shale W/lime strs:	3050	
Lime & Shale:	3315	
Shale W/lime Strs:	3440	
Lime & Shale:	3670	
Shale & Lime:	3740	
Lime:	4170	
Lime & Shale:	4235	
Lime:	4361	
Chert & Lime:	4400	
Shale & Lime:	4577	
Lime:	4655	
Sand:	4685	

T. D.
RECEIVED
 STATE CORPORATION COMMISSION
 NOV - 7 1956
 CONSERVATION DIVISION
 Wichita, Kansas

STATE OF KANSAS,)
 SEDGWICK COUNTY,) SS:

I hereby certify that the above is a true and correct copy of Drillers Log of well drilled in the NE NE SW of Section 3, Township 30, Range 10 West, Kingman County, Kansas.

WELCH & OLSSON DRILLING COMPANY, INC.
 BY [Signature]
 R. E. WELCH

Subscribed and sworn to before me this 5th day of November, 1956.

My commission expires: June 12, 1959

[Signature]
 Edith Erker, Notary Public.

PLUGGING
 FILE SEC. 3 T. 30 R. 10W
 BOOK PAGE 113 LINE 10