


WELL PLUGGING RECORD

Give All Information Completely  
Make Required Affidavit  
Mail or Deliver Report to:  
Conservation Division  
State Corporation Commission  
800 Biting Building  
Wichita, Kansas

Hodgeman County. Sec. 20 Twp. 22S Rge. 21 (~~E~~) W (W)  
Location as "NE/CNW/SW" or footage from lines Center SW SW  
Lease Owner The Atlantic Refining Company  
Lease Name Mooney Well No. 1  
Office Address P. O. Box 17, Great Bend, Kansas  
Character of Well (completed as Oil, Gas or Dry Hole) Dry hole.  
Date well completed Sept. 3 19 53  
Application for plugging filed Sept. 2 19 53  
Application for plugging approved Sept. 2 19 53  
Plugging commenced Sept. 2 19 53  
Plugging completed Sept. 2 19 53  
Reason for abandonment of well or producing formation Dry hole.

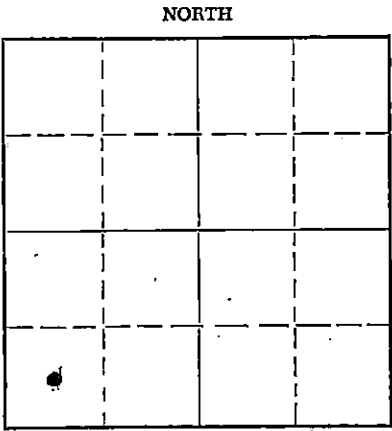

Locate well correctly on above Section Plat

If a producing well is abandoned, date of last production 19  
Was permission obtained from the Conservation Division or its agents before plugging was commenced? Yes

Name of Conservation Agent who supervised plugging of this well M. A. Rives, Pratt, Kansas  
Producing formation X Depth to top X Bottom X Total Depth of Well 4895 Feet  
Show depth and thickness of all water, oil and gas formations.

OIL, GAS OR WATER RECORDS

CASING RECORD

FORMATION	CONTENT	FROM	TO	SIZE	PUT IN	PULLED OUT
				10-3/4"	318	0

Describe in detail the manner in which the well was plugged, indicating where the mud fluid was placed and the method or methods used in introducing it into the hole. If cement or other plugs were used, state the character of same and depth placed, from \_\_\_\_\_ feet to \_\_\_\_\_ feet for each plug set.

Ran drill pipe to 2400'.  
Circulated heavy mud. Pumped bridging plug to 300' with 20 sacks cement on top. Set bridging plug at 40' with 10 sacks. Cement on same. Checked after 12 hours. Cement had not settled. O. K.

(If additional description is necessary, use BACK of this sheet)

Name of Plugging Contractor \_\_\_\_\_  
Address \_\_\_\_\_

STATE OF KANSAS, COUNTY OF BARTON, ss.  
Vance H. Louthan (employee of owner) or (owner/operator) of the above-described well, being first duly sworn on oath, says: That I have knowledge of the facts, statements, and matters herein contained and the log of the above-described well as filed and that the same are true and correct. So help me God.

(Signature) Vance H. Louthan  
P. O. Box 17, Great Bend, Kansas (Address)

SUBSCRIBED AND SWORN TO before me this 23 day of October, 19 53

My commission expires 7-18-55

Notary Public.  
STATE CORPORATION COMMISSION  
OCT 24 1953  
CONSERVATION DIVISION  
Wichita, Kansas  
10-24-53

PLUGGING  
FILE SEC 20 T 22 R 21 W  
BOOK PAGE 126 LINE 44

THE ATLANTIC REFINING COMPANY  
830 Kennedy Building  
Tulsa, Oklahoma

WELL LOG

Mooney No. 1

Location: C SW SW of 20-22S-21W, Hodgeman County, Kansas.

Lease Number: KS-12,626

Elevations: RKB 2206', DF 2203', GL 2201'

Spudded: August 11, 1953

Reached T.D.: September 1, 1953

Contractor: Lohmann-Johnson Drilling Company, Inc.

Casing Record: Ran 15 joints (318') of 10-3/4" OD 32# J & L seamless casing and set at 328' RKB with 250 sacks Pozmix cement plus 200# calcium chloride.

FORMATION RECORD:

Shale & sand	0' - 120'
Shale & shells	120' - 304'
Sand & shale	304' - 330'
Blue shale	330' - 500'
Red bed	500' - 800'
Sand	800' - 975'
Shale & sand	975' - 1280'
Shale & shells	1280' - 1335'
Anhydrite	1335' - 1380'
Shale & shells	1380' - 1800'
Shale & salt	1800' - 1855'
Shale & shells	1855' - 1975'
Lime & shale	1975' - 2240'
Lime (broken)	2240' - 2520'
Lime	2520' - 2584'
Lime & shale	2584' - 3465'
Lime	3465' - 3743'
Lime & shale	3743' - 3809'
Lime	3809' - 4446'
Lime & chert	4446' - 4464'
Chert	4464' - 4519'
Lime	4519' - 4609'
Lime & chert	4609' - 4685'
Lime	4685' - 4713'
Lime & chert	4713' - 4730'
Lime & shale	4730' - 4778'
Dolomite	4778' - 4794'
Lime	4794' - 4831'
Shale & lime	4831' - 4895'

4895' T.D.

September 3, 1953:

Ran 2400' drill pipe. Circulated heavy mud. Set bridge plug at 300'. Mixed 20 sacks cement. Put on top of plug. Set 2 bridge plugs at 40'. Pumped in 10 sacks cement. Fluid did not drop down hole. Checked plugs, same holding. Well plugged and abandoned in accordance with Kansas State Rules and Regulations. Dry hole.

\*\*\*\*\*

rpr

PLUGGING  
FILE SEC 20 Y 22 R 210  
BOOK PAGE 126 LINE 44

RECEIVED  
STATE CORPORATION COMMISSION

SEP 22 1953