


STATE OF KANSAS  
STATE CORPORATION COMMISSION  
Give All Information Completely  
Make Required Affidavit  
Mail or Deliver Report to:  
Conservation Division  
State Corporation Commission  
211 No. Broadway  
Wichita, Kansas

WELL PLUGGING RECORD

Hodgeman County, Sec. 19 Twp. 22 Rge. 21 (E) W(W)

Location as "NE/CNW&SW" or footage from lines SE NE  
Lease Owner Beardmore Drilling Company  
Lease Name Mooney "A" Well No. 1  
Office Address 700 One Twenty Bldg., Wichita, Kansas  
Character of Well (completed as Oil, Gas or Dry Hole) dry hole  
Date well completed 5-10 19 66  
Application for plugging filed 5-10 19 66  
Application for plugging approved 5-10 19 66  
Plugging commenced 5-10 19 66  
Plugging completed 5-10 19 66  
Reason for abandonment of well or producing formation dry hole

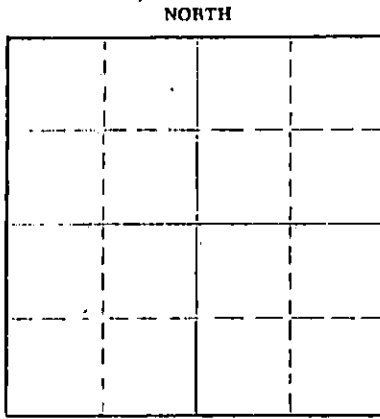

Locate well correctly on above Section Plot

If a producing well is abandoned, date of last production 19  
Was permission obtained from the Conservation Division or its agents before plugging was commenced? yes

Name of Conservation Agent who supervised plugging of this well Edgar Eves  
Producing formation \_\_\_\_\_ Depth to top \_\_\_\_\_ Bottom \_\_\_\_\_ Total Depth of Well 4460 Feet  
Show depth and thickness of all water, oil and gas formations.

OIL, GAS OR WATER RECORDS				CASING RECORD		
FORMATION	CONTENT	FROM	TO	SIZE	PUT IN	PULLED OUT
Surface clay & sand		0	300'			
Shale & shells		300'	333'	8-5/8"	333'	0

Describe in detail the manner in which the well was plugged, indicating where the mud fluid was placed and the method or methods used in introducing it into the hole. If cement or other plugs were used, state the character of same and depth placed, from \_\_\_\_\_ feet to \_\_\_\_\_ feet for each plug set.

0 to 45'	-	15 sacks cement
45'	-	wood plug
45' to 275'	-	heavy mud
275' to 380'	-	35 sacks cement
380'	-	wood plug
380' to 4460'	-	heavy mud

RECEIVED  
STATE CORPORATION COMMISSION  
MAY 25 1966  
CONSERVATION DIVISION  
Wichita, Kansas

(If additional description is necessary, use BACK of this sheet)  
Name of Plugging Contractor Gabbert-Jones, Inc.  
Address 514 Opheum Building, Wichita, Kansas

STATE OF Kansas, COUNTY OF Sedgwick, ss.  
Heber Beardmore (owner or operator) of the above-described

well, being first duly sworn on oath, says: That I have knowledge of the facts, statements, and matters herein contained and the log of the above-described well as filed and that the same are true and correct. So help me God.

(Signature) Heber Beardmore  
Heber Beardmore, Managing Partner  
(Address)

SUBSCRIBED AND SWORN to before me this 23rd day of May, 19 66

My commission expires 7-13-67  
Shirley Ann Jackson  
Notary Public.

GABBERT-JONES, INC.  
WICHITA, KANSAS  
DRILLERS' WELL LOG

MOONEY "A" #1  
C SE NE SECTION 19-22S-21W  
HODGEMAN COUNTY, KANSAS

COMMENCED: APRIL 28, 1966  
COMPLETED: MAY 10, 1966

OPERATOR - BEARDMORE DRILLING COMPANY

DEPTH		FORMATION	REMARKS
From	To		
0	300	SURFACE CLAY AND SAND	
300	333	SHALE	RAN 14 JOINTS OF 8-5/8" CASING, SET @ 333' w/200 SACKS CEMENT.
333	1330	SHALE, SHELLD AND RED BED	
1330	1395	ANHYDRITE	
1395	2120	SHALE AND SHELLS	
2120	3820	LIME AND SHALE	
3820	4427	LIME	
4426	4431	CHERT AND LIME	
4431	4438	LIME	
4438	4460	LIME AND CHERT	
4460	TD		DRY AND ABANDONED.

RECEIVED  
STATE CORPORATION COMMISSION  
MAY 25 1966  
CONSERVATION DIVISION  
Wichita, Kansas

I, E. E. HALL, CERTIFY THIS IS A CORRECT COPY OF THE DRILLERS' LOG FOR WELL DRILLED IN THE C SE NE SECTION 19-22S-21W, HODGEMAN COUNTY, KANSAS, TO THE BEST OF MY KNOWLEDGE AND BELIEF.

*E. E. Hall*  
E. E. HALL

STATE OF KANSAS )  
                          ) SS  
COUNTY OF SEDGWICK )

BEFORE ME, THE UNDERSIGNED, A NOTARY PUBLIC WITHIN AND FOR SAID COUNTY AND STATE, ON THIS 12TH DAY OF MAY, 1966, PERSONALLY APPEARED E. E. HALL TO ME PERSONALLY KNOWN TO BE THE IDENTICAL PERSON WHO EXECUTED THE WITHIN AND FOREGOING INSTRUMENT AND ACKNOWLEDGED TO ME THAT HE EXECUTED THE SAME AS HIS FREE AND VOLUNTARY ACT AND DEED FOR THE USES AND PURPOSES THEREIN SET FORTH.

IN WITNESS WHEREOF, I HAVE HEREUNTO SET MY HAND AND OFFICIAL SEAL THE DAY AND YEAR LAST ABOVE WRITTEN.

*Barbara J. Layton*  
BARBARA J. LAYTON, NOTARY PUBLIC

MY COMMISSION EXPIRES FEBRUARY 1, 1968.