


STATE OF KANSAS
STATE CORPORATION COMMISSION

Give All Information Completely
Make Required Affidavit
Mail or Deliver Report to:
Conservation Division
State Corporation Commission
211 No. Broadway
Wichita, Kansas

RECEIVED
STATE CORPORATION COMMISSION
JUL 20 1957

7-20-57 WELL PLUGGING RECORD

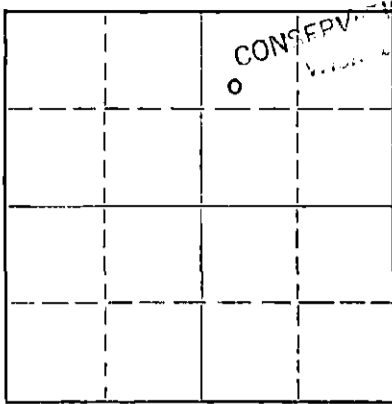

Locate well correctly on above Section Plat

Hodgeman County, Sec. 19 Twp. 22S Rge. (E) 21 (W)
Location as "NE/CNW&SW" or footage from lines 1001' FNL & 330' FWL of NE/4
Lease Owner Kewanee Oil Company
Lease Name Mooney Well No. 1
Office Address P. O. Box 360, Hoisington, Kansas
Character of Well (completed as Oil, Gas or Dry Hole) Dry Hole
Date well completed July 17, 1957
Application for plugging filed July 17, 1957
Application for plugging approved July 17, 1957
Plugging commenced July 17, 1957
Plugging completed July 17, 1957
Reason for abandonment of well or producing formation Dry Hole

If a producing well is abandoned, date of last production 19
Was permission obtained from the Conservation Division or its agents before plugging was commenced? Yes - permission from Mr. Rives - 7-17-57 - verbal.

Name of Conservation Agent who supervised plugging of this well Mr. M. A. Rives, Box 8, Pratt, Kansas
Producing formation _____ Depth to top _____ Bottom _____ Total Depth of Well 456 1/2 Feet
Show depth and thickness of all water, oil and gas formations.

OIL, GAS OR WATER RECORDS

CASING RECORD

FORMATION	CONTENT	FROM	TO	SIZE	PUT IN	PULLED OUT
Heebner	Dry	3770		8-5/8"	504'	None
Toronto	Dry	3788				
Brown Lansing	Dry	3831				
Lansing	Dry	3855				
Mississippi	Dry	4446				
Misener	Dry	4548	456 1/2 TD			

Describe in detail the manner in which the well was plugged, indicating where the mud fluid was placed and the method or methods used in introducing it into the hole. If cement or other plugs were used, state the character of same and depth placed, from _____ feet to _____ feet for each plug set.

Filled hole with mud to 500'.
Halliburton plug at 500'.
20 sacks cement on top of plug from 500'.
Filled hole with mud to 35'.
Halliburton plug spotted at 35'.
1/3 sack of cottonseed hulls on top of plug.
Filled to top of casing with cement (approximately 10 sacks)
Casing completely filled to surface.

(If additional description is necessary, use BACK of this sheet)

Name of Plugging Contractor Graham-Michaelis Drilling Company
Address Wichita, Kansas.

STATE OF Kansas, COUNTY OF Barton, ss.
Peter Blanda (employee of owner) or (owner or operator) of the above-described well, being first duly sworn on oath, says: That I have knowledge of the facts, statements, and matters herein contained and the log of the above-described well as filed and that the same are true and correct. So help me God.

(Signature) Peter Blanda
P. O. Box 360, Hoisington, Kansas.
(Address)

SUBSCRIBED AND SWORN TO before me this 19th day of July, 1957.
Everett W. Fuller
Notary Public.

My commission expires September 21, 1957

PLUGGING
FILE SEC 19 T 22 R 21 W
BOOK PAGE 30 LINE 6

MOONEY #1

Well Record

Location: NE/4 Section 19-22S-21W
Hodgeman County, Kansas

Commenced: July 1, 1957
Completed: July 17, 1957
(rotary)

Operator: Kewanee Oil Company
Box 360
Herington, Kansas

Contractor: Graham-Michaels Drilling Co.
211 North Broadway
Wichita, Kansas

Casing Record: 8 5/8" 5504' W/300 sacks Pozmix Cement

	<u>LOG</u>
Clay & Sand	100
Clay & Shale	240
Sand	300
Blue Shale	508
Shale	604
Red Sed & Shale	685
Anhydrite	700
Shale	770
Sand	970
Sale & Shells	1337
Anhydrite	1364
Shale	1715
Shale & Lime Streaks	1910
Shale	2300
Shale & Lime	2473
Lime	2919
Lime & Shale	3365
Shale	3465
Lime-Shale	3752
Lime	3971
Lime-Shale	4013
Lime	4565, RTD.

STATE OF KANSAS)
) ss.
COUNTY OF SEDGWICK)

The undersigned, GRAHAM-MICHAELIS DRILLING COMPANY, hereby certifies that the above log is a true and correct log of the formations encountered in drilling the above well as reflected by the Daily Drilling Report.

GRAHAM-MICHAELIS DRILLING COMPANY

By John L. James
John L. James, Geologist.

Subscribed and sworn to before me this 25th day of July, 1957.

G. D. Greer

My commission expires: 1/7/61.

RECEIVED
STATE CORPORATION COMMISSION
JUL 26 1957
CONSERVATION DIVISION
Wichita, Kansas

PLUGGING
FILE: SEC 19, T 22, R 21W
BOOK PAGE 30 LINE 6