


STATE OF KANSAS
STATE CORPORATION COMMISSION

WELL PLUGGING RECORD

Give All Information Completely
Make Required Affidavit
Mail or Deliver Report to
Conservation Division
State Corporation Comm.
245 North Water
Wichita, KS 67202

Hodgeman County, Sec. 6 Twp. 22 Rge. 22 E/W
Location as "NE/CNW $\frac{1}{4}$ SW $\frac{1}{4}$ " or footage from lines
1980' FSL, 660' FEL

Lease Owner Cities Service Oil Co.
Lease Name Barnett "A" Well No. 2 SWD
Office Address 700 Sutton Place Bldg., Wichita, Ka. 67202
Character of Well (Completed as Oil, Gas or Dry Hole) SWD
Date Well completed 10-26 19 62
Application for plugging filed 5-24 19 77
Application for plugging approved 5-24 19 77
Plugging commenced 5-24 19 77
Plugging completed 5-24 19 77
Reason for abandonment of well or producing formation _____

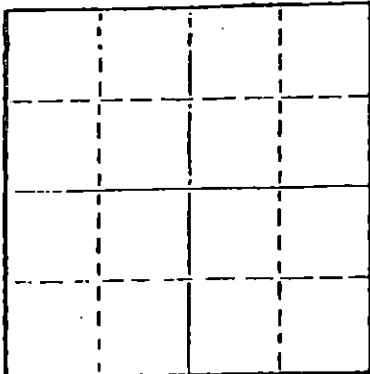

Locate well correctly on above Section Plat

If a producing well is abandoned, date of last production --- 19 --

Was permission obtained from the Conservation Division or its agents before plugging was commenced? Yes

Name of Conservation Agent who supervised plugging of this well Clarence Thomas
Producing formation _____ Depth to top _____ Bottom _____ Total Depth of Well 4502'
Show depth and thickness of all water, oil and gas formations.

OIL, GAS OR WATER RECORDS

CASING RECORD

FORMATION	CONTENT	FROM	TO	SIZE	PUT IN	PULLED OUT
				8-5/8"	249'	None
				4 1/2"	4500	None

Describe in detail the manner in which the well was plugged, indicating where the mud fluid was placed and the method or methods used in introducing it into the hold. If cement or other plugs were used, state the character of same and depth placed, from _____ feet to _____ feet for each plug set.

Ran 28 joints 2" tubing bottom at 900'. Pumped 1 sack hulls 2 sacks gel, 20 sacks 50-50 Pozmix. Shut in, could not pump in at 500#. Pulled out 10 joints tubing at 600' mixed and pumped 1 sack hulls, 2 sacks gel, 30 sacks 50-50 Pozmix. Pumping in at 300#. Pulled 10 joints tubing bottom at 240. Mixed and pumped 30 sacks 50-50 Pozmix at 300#. Shut in, not flowing back. Pulled and laid down 6 joints bottom at 60'. Mixed, pumped 10 sacks 50-50 pozmix. Circulated to bottom collar. Pulled out tubing

(If additional description is necessary, use BACK of this sheet)

Name of Plugging Contractor _____

STATE OF Kansas COUNTY OF Sedgwick, ss. _____ (employee of owner) or (owner or operator)

of the above-described well, being first duly sworn on oath, says: That I have knowledge of the facts, statements, and matters herein contained and the log of the above-described well as filed and that the same are true and correct. So help me God.

Glenn E. Meier
STATE NOTARY PUBLIC
Sedgwick County, Kansas

(Signature) W. J. Devaney W. J. Devaney
700 Sutton Place Bldg, Wichita, Kansas
(Address)

SUBSCRIBED AND SWORN TO before me this 27TH day of MAY, 1977

Glenn E. Meier
Glenn E. Meier Notary Public.

My commission expires 6/3/77

RECEIVED
STATE CORPORATION COMMISSION

MAY 31 1977

CONSERVATION DIVISION
Wichita, Kansas

DRILLERS LOG

Imperial Oil Company
780 Fourth National Building
Wichita, Kansas

BARNETT NO. 2
C NE SE Sec. 6-22S-22W
Hodgeman County, Kansas

Total Depth: 4502

Elevation: 2261 K.B.

Commenced: June 6, 1962 Completed June 18, 1962

Contractor: Imperial Oil of Kansas, Inc.
Wichita, Kansas

Casing Record: Set 8-5/8" surface pipe at 249' with 215 sacks cement
Set 4-1/2" production pipe at 4500' with 125 sacks cement

Figures indicate bottom of formations:

TOPS

Surface Clay & Rock	105'	Heebner	3812 (-1551)
Shale	249'	Lansing	3890 (-1629)
Shale & Sand	810'	Base Kansas City	4206 (-1945)
Anhydrite	820'	Cherkee Shale	4388 (-2127)
Shale & Sand	965'	Mississippi (Warsaw)	4500 (-2239)
Red Bed & Shale	1635'	Rotary Total Depth	4502 (-2241)
Shale & Shells	2040'		
Shale & Lime	2460'		
Lime	3130'		
Lime & Shale	3605'		
Shale & Chalk	3705'		
Shale & Lime	3840'		
Lime	4502'		

We hereby certify this to be a correct and accurate log of the above described well, as shown on the daily drilling reports.

IMPERIAL OIL COMPANY

BY Raymond R. Dombaugh
Raymond R. Dombaugh

Subscribed and sworn to before me this 2nd day of July, 1962.

My commission expires:

May 25, 1966.

RECEIVED
STATE CORPORATION COMMISSION

MAY 31 1977

CONSERVATION DIVISION
Wichita, Kansas

Margaret C. Phillips
Notary Public