

STATE OF KANSAS  
STATE CORPORATION COMMISSION


Give All Information Completely  
Make Required Affidavit  
Mail or Deliver Report to:  
Conservation Division  
State Corporation Commission  
211 No. Broadway  
Wichita, Kansas

WELL PLUGGING RECORD

Hodgeman County, Sec. 5 Twp. 22S Rge. (E) 22W(W)

Location as "NE/CNW&SW" or footage from lines. C-SW-SW  
Lease Owner Sunray DX Oil Company  
Lease Name Edith Barnett Well No. 2  
Office Address 321 West Douglas, Wichita 2, Kansas  
Character of Well (completed as Oil, Gas or Dry Hole) Dry Hole  
Date well completed 19  
Application for plugging filed July 30, 19 62  
Application for plugging approved July 29, 19 62  
Plugging commenced July 29, 19 62  
Plugging completed July 29, 19 62  
Reason for abandonment of well or producing formation Non Commerical

NORTH

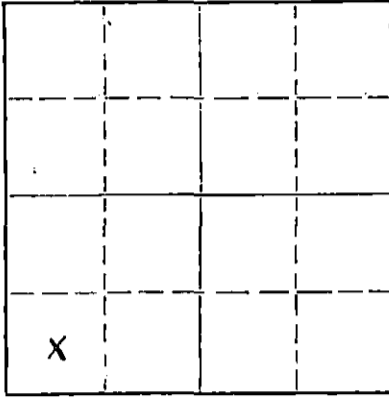

Locate well correctly on above  
Section Plat

If a producing well is abandoned, date of last production 19  
Was permission obtained from the Conservation Division or its agents before plugging was commenced? Yes

Name of Conservation Agent who supervised plugging of this well Hugh Scott  
Producing formation Depth to top Bottom Total Depth of Well 4640' Feet  
Show depth and thickness of all water, oil and gas formations.

OIL, GAS OR WATER RECORDS

CASING RECORD

FORMATION	CONTENT	FROM	TO	SIZE	PUT IN	PULLED OUT
Mississippi	Water	4584'	4623'	8 5/8"	264'	-0-

Describe in detail the manner in which the well was plugged, indicating where the mud fluid was placed and the method or methods used in introducing it into the hole. If cement or other plugs were used, state the character of same and depth placed, from feet to feet for each plug set.  
Filled hole with mud from total depth to 245' and dumped thirty-five sacks of cement.  
Filled hole with mud and dumped fifteen sacks of cement to surface and cap well.

RECEIVED  
STATE CORPORATION COMMISSION  
AUG 7 1962  
8-7-62  
CONSERVATION DIVISION  
Wichita, Kansas

(If additional description is necessary, use BACK of this sheet)  
Name of Plugging Contractor Stickle Drilling Company  
Address 1100 Bitting Building, Wichita, Kansas

STATE OF Kansas COUNTY OF Sedgwick ss.  
Gary W. Pierce (employee of owner) or (owner or operator) of the above-described well, being first duly sworn on oath, says: That I have knowledge of the facts, statements, and matters herein contained and the log of the above-described well as filed and that the same are true and correct. So help me God.

(Signature) Gary W. Pierce  
321 West Douglas, Wichita 2, Kansas  
(Address)

SUBSCRIBED AND SWORN TO before me this 3rd day of August, 19 62

My commission expires July 13, 1963  
Messinger Notary Public.

Sunray DX Oil Company  
Tulsa, Oklahoma

Tulsa, Oklahoma  
August 2, 1962

Contractor: Stickle Drilling Company  
Date Commenced: July 15, 1962  
Date Completed: July 29, 1962

Barnett #2  
Ctr. SW SW Sec. 5-22S-22W  
Hodgeman County, Kansas

DRILLER'S LOG

Depth Figures Indicate Base of Formation:

Clay and Sand	266
Shale and Sand	1200
Shale and Shells	1623
Red Bed	1834
Shale	2333
Shale and Lime	2460
Lime and Shale	2608
Lime	2770
Shale and Lime	3029
Shale and Chalk	3133
Lime and Shale	3293
Shale and Lime	3360
Shale and Chalk	3500
Lime and Shale	3648
Shale, Chalk and Lime Streaks	3788
Lime and Shale	3953
Lime	4492
Shale, Chert and Lime	4540
Lime	4638
Shale	4640 TD

**RECEIVED**  
STATE CORPORATION COMMISSION

AUG 7 1962

CONSERVATION DIVISION  
Wichita, Kansas

I, Fred E. Stickle, hereby certify the above to be a true and complete Driller's Log of Sunray DX Oil Company's Barnett #2, Ctr. SW SW Sec. 5-22S-22W, Hodgeman County, Kansas;

*Paul D. Drey*  
Notary Public

My Commission expires Sept 27, 1965

*Fred E. Stickle*  
FRED E. STICKLE