


Give All Information Completely  
Make Required Affidavit  
Mail or Deliver Report to:  
Conservation Division  
State Corporation Commission  
211 No. Broadway  
Wichita, Kansas

WELL PLUGGING RECORD

Hodgeman County. Sec. 3 Twp. 22S Rge. 22 ~~(W)~~ (W)  
Location as "NE/CNW/SW" or footage from lines C NW SE

Lease Owner Socony Mobil Oil Company, Inc.  
Lease Name Everett Salmans Well No. 10 Core Hole  
Office Address 300 No. Broadway - Wichita, Kansas 67202  
Character of Well (completed as Oil, Gas or Dry Hole) Core Test Hole  
Date well completed 4-11-64 19\_\_\_\_  
Application for plugging filed 4-24-64 19\_\_\_\_  
Application for plugging approved 4-24-64 19\_\_\_\_  
Plugging commenced 4-28-64 19\_\_\_\_  
Plugging completed 4-28-64 19\_\_\_\_  
Reason for abandonment of well or producing formation Plug Core Test Hole

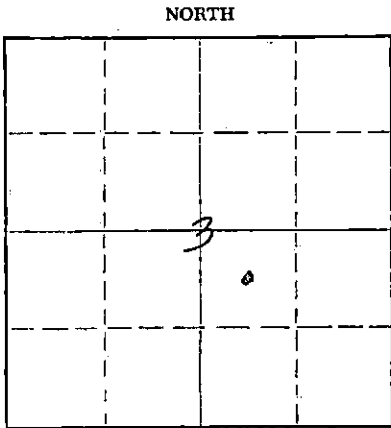

Locate well correctly on above  
Section Plat

If a producing well is abandoned, date of last production \_\_\_\_\_ 19\_\_\_\_  
Was permission obtained from the Conservation Division or its agents before plugging was commenced? \_\_\_\_\_

Name of Conservation Agent who supervised plugging of this well Hugh Scott  
Producing formation \_\_\_\_\_ Depth to top \_\_\_\_\_ Bottom \_\_\_\_\_ Total Depth of Well \_\_\_\_\_ Feet  
Show depth and thickness of all water, oil and gas formations.

OIL, GAS OR WATER RECORDS

CASING RECORD

FORMATION	CONTENT	FROM	TO	SIZE	PUT IN	PULLED OUT

Describe in detail the manner in which the well was plugged, indicating where the mud fluid was placed and the method or methods used in introducing it into the hole. If cement or other plugs were used, state the character of same and depth placed, from \_\_\_\_\_ feet to \_\_\_\_\_ feet for each plug set.

Mixed 6 sacks of zeogel with 40 barrels of salt water, Circulated 8 joints to 250'.  
Circulated 15 minutes. Mixed poz mix and cement to surface with 85 sacks.

RECEIVED  
STATE CORPORATION COMMISSION

JUN 8 1964

CONSERVATION DIVISION  
Wichita, Kansas

(If additional description is necessary, use BACK of this sheet)  
Name of Plugging Contractor Socony Mobil Oil Company, Inc. (Pulling Unit)  
Address 300 No. Broadway - Wichita, Kansas

STATE OF Kansas, COUNTY OF Sedgwick, ss.  
T. V. Herriage (employee of owner) ~~is a competent person~~ of the above-described well, being first duly sworn on oath, says: That I have knowledge of the facts, statements, and matters herein contained and the log of the above-described well as filed and that the same are true and correct. So help me God.

(Signature) T. V. Herriage Dist. Acctg Group Supv

300 No. Broadway - Wichita, Kansas - 67202  
(Address)

SUBSCRIBED AND SWORN TO before me this 4th day of June, 1964

My commission expires 4-4-66

Jack Bearden  
Notary Public.